


CLAIM OF BENEFICIAL USE MAP

UNDER APPLICATION R-84619; PERMIT R-13058


GOV'T. LOT 3 (NW1/4 SW1/4) SEC 19 T 34S R 46E W.M.

U.S.G.S. QUAD - THREE FORKS, OREG. - 7 1/2'

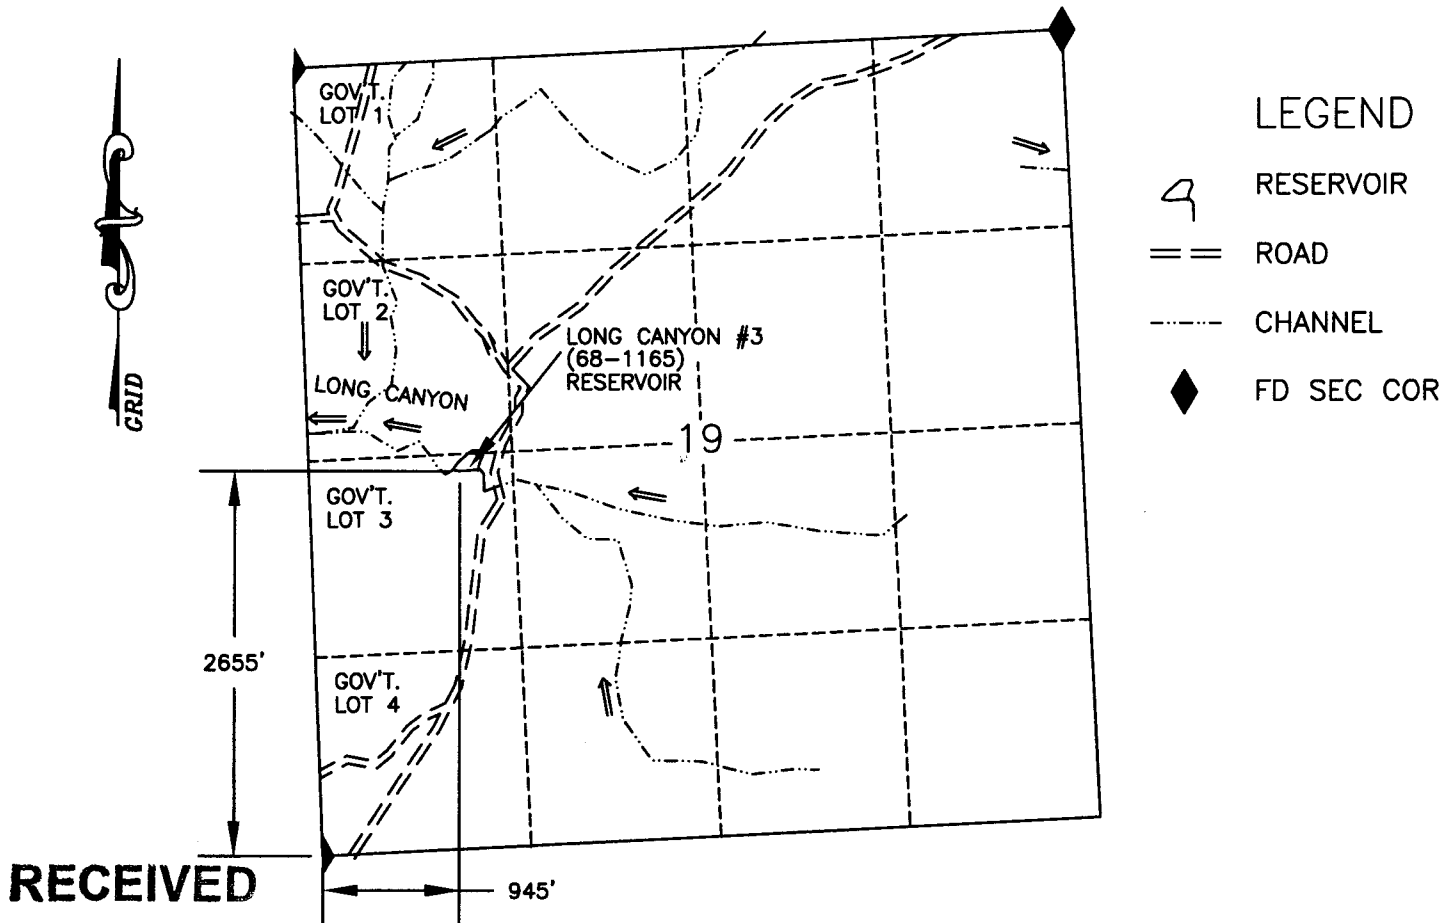

DEC 18 2003 LONG CANYON #3 (68-1165) RESERVOIR

WATER RESOURCES DEPT
SALEM, OREGON

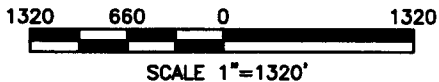

I, Thomas D. Terry, ADM Division of Field Support agree to the findings of the CWRE and do submit this site report and map as my Claim of Beneficial Use of the water as provided under the terms and conditions of my Permit R-13058.

Thomas D. Terry



THIS MAP IS FOR THE PURPOSE OF LOCATING A WATER RIGHT AND IS NOT INTENDED TO PROVIDE LEGAL DIMENSIONS FOR LOCATION OF PROPERTY BOUNDARIES.

ACAD2000
DWG FILE: LONGCAN3-BENE

UNITED STATES DEPARTMENT OF THE INTERIOR BUREAU OF LAND MANAGEMENT DIVISION OF OPERATIONS VALE DISTRICT	
LONG CANYON #3 (68-1165) RESERVOIR	
DESIGNED:	
REVIEWED:	<i>Long 3. Hall</i>
APPROVED:	<i>Thomas D. Terry</i> ADM OPERATIONS AND FIELD SERVICES
DRAWN: CG	SCALE: 1"=1320'
DATE: 09/17/03	SHEET 1 OF 1
DRAWING NO. OR-03-9172.45-1211	