


CLAIM OF BENEFICIAL USE MAP

UNDER APPLICATION R-84620; PERMIT R-13059

NE1/4 NW1/4 SEC 11 T 37S R 37E W.M.

U.S.G.S. QUAD - DRY CREEK BENCH, OREG. - 7 1/2'

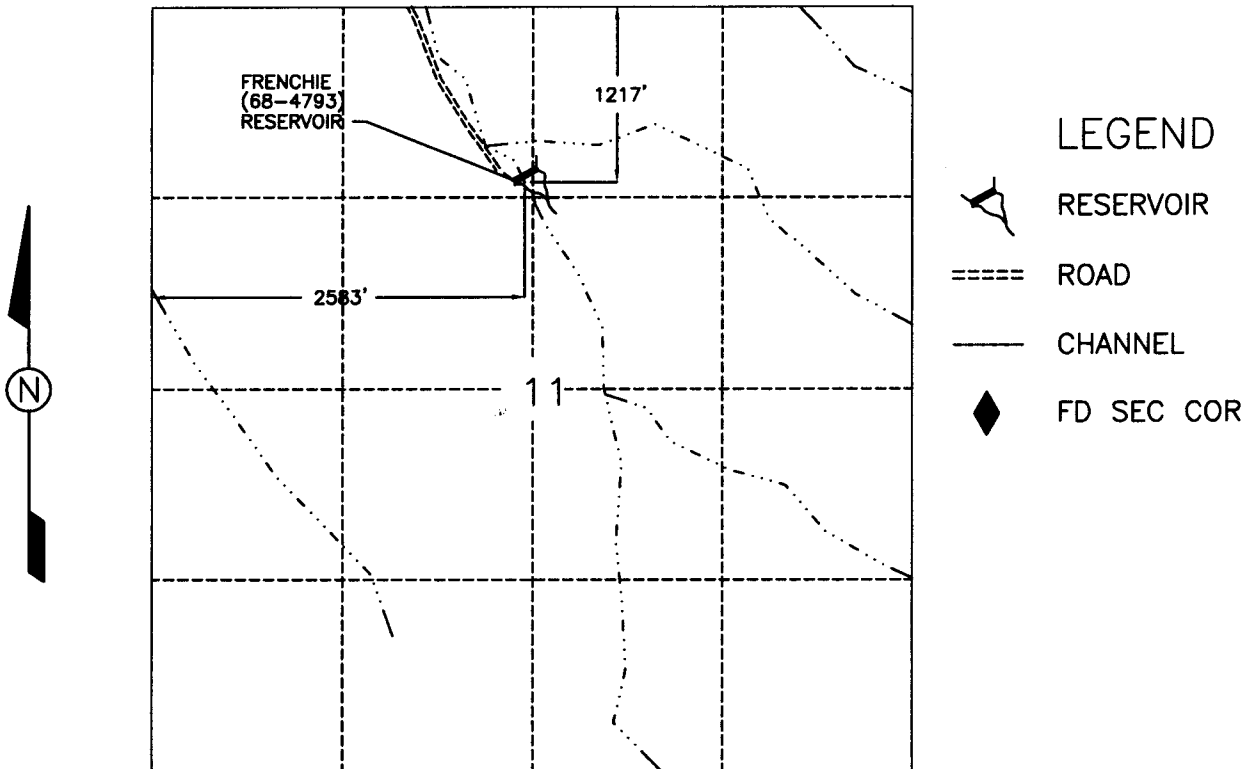

RECEIVED

DEC 18 2003

WATER RESOURCES DEPT
SALEM, OREGON

FRENCHIE (68-4793) RESERVOIR

1320 660 0 1320
SCALE 1"=1320'

I, Thomas D. Terry, ADM Division of Field Support agree to the findings of the CWRE and do submit this site report and map as my Claim of Beneficial Use of the water as provided under the terms and conditions of my Permit R-13059

Thomas D. Terry



THIS MAP IS FOR THE PURPOSE OF LOCATING A WATER RIGHT AND IS NOT INTENDED TO PROVIDE LEGAL DIMENSIONS FOR LOCATION OF PROPERTY BOUNDARIES.

ACAD2000
DWG FILE FRENCHIE-BENE

UNITED STATES DEPARTMENT OF THE INTERIOR BUREAU OF LAND MANAGEMENT DIVISION OF OPERATIONS VALE DISTRICT	
FRENCHIE (68-4793) RESERVOIR	
DESIGNED:	
REVIEWED:	<u>Tom D. Terry</u>
APPROVED:	<u>Tom D. Terry</u> ADM OPERATIONS AND FIELD SERVICES
DRAWN: CG	SCALE: 1"=1320'
DATE: 09/03/03	SHEET 1 OF 1
DRAWING NO. OR-03-9172.45-1206	