


TOWNSHIP 2 SOUTH, RANGE 13 EAST, W.M.
WASCO COUNTY, OREGON

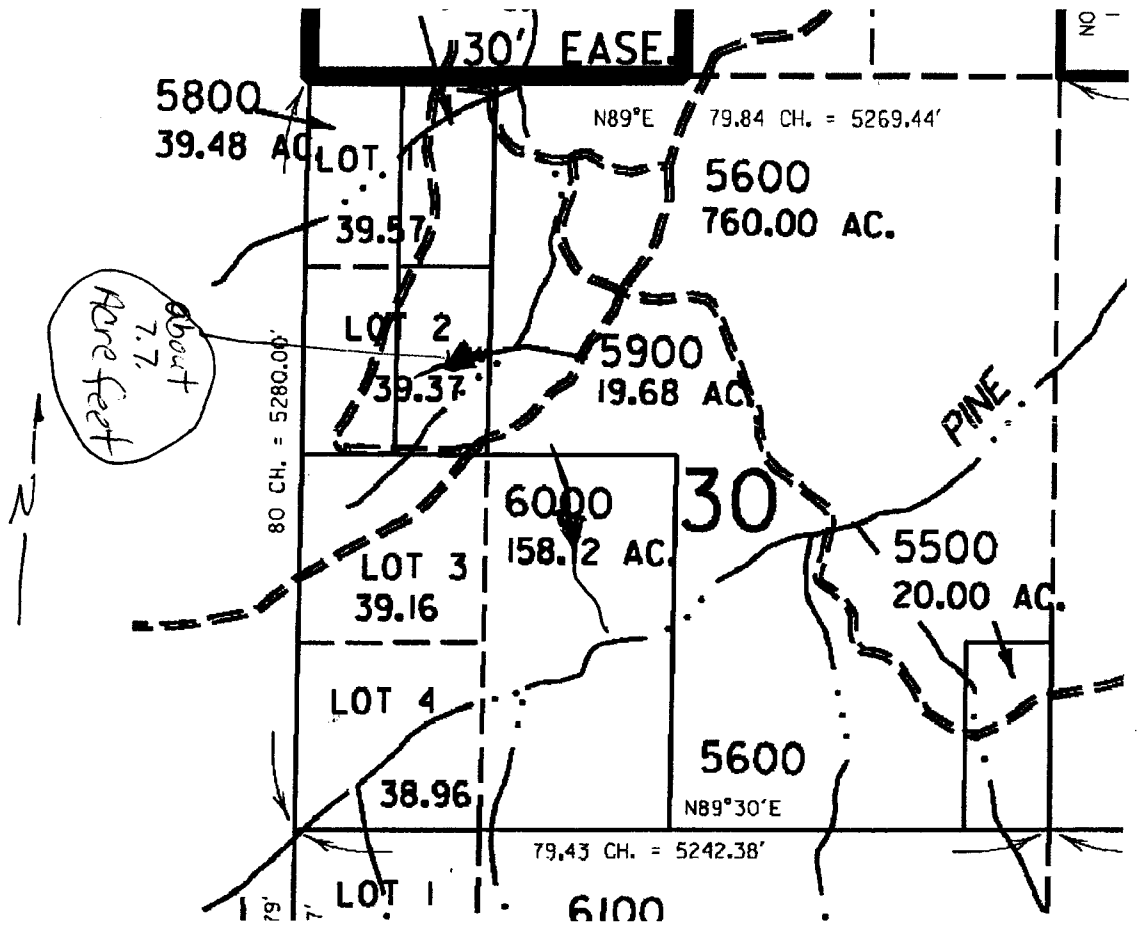

1 INCH = 1320 FEET
WORK COPY GC/WRD *5/6/2004*

RECEIVED

JUL 01 2004

WATER RESOURCES DEPT
SALEM, OREGON