

CLACKAMAS COUNTY

1" = 200'

RECEIVED

FEB 12 2003

WATER RESOURCES DEPT.
SALEM, OREGON



↑
N
CURRENT
proposed
reservoir

Reservoir located
250' NW from SE
corner post of 2SE
27

SEE MAP 2 5E 22

46-04

CEDAR

CREEK

HOOD

HIGHWAY


NO.

26

RECEIVED

JAN 18 2001

WATER RESOURCES DEPT.
SALEM, OREGON

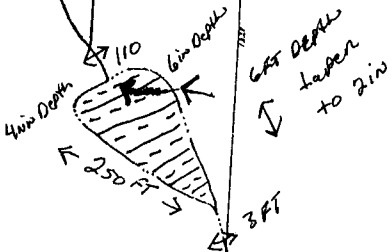

CREEK

600
11.60Ac.

300
9.42Ac.

100
2.15Ac.

900
0.80Ac.

500
1.06Ac.

400
2.06Ac.

200
0.92Ac.

1000
3.50Ac.

1400
0.66Ac.

1500
9.06Ac.

1600
4.84Ac.

1700
5.51Ac.

1800
0.18Ac.

1701
4.07Ac.

1900
4.75Ac.

2100
8.48Ac.

2000
5.00Ac.