

CLACKAMAS COUNTY

1"=200'

Tax Lot 01300




Pond located
575' NW from
SE corner post
of 2SE 27

SEE MAP 2 5E 22

RECEIVED

FEB 12 2003

WATER RESOURCES DEPT.
SALEM, OREGON

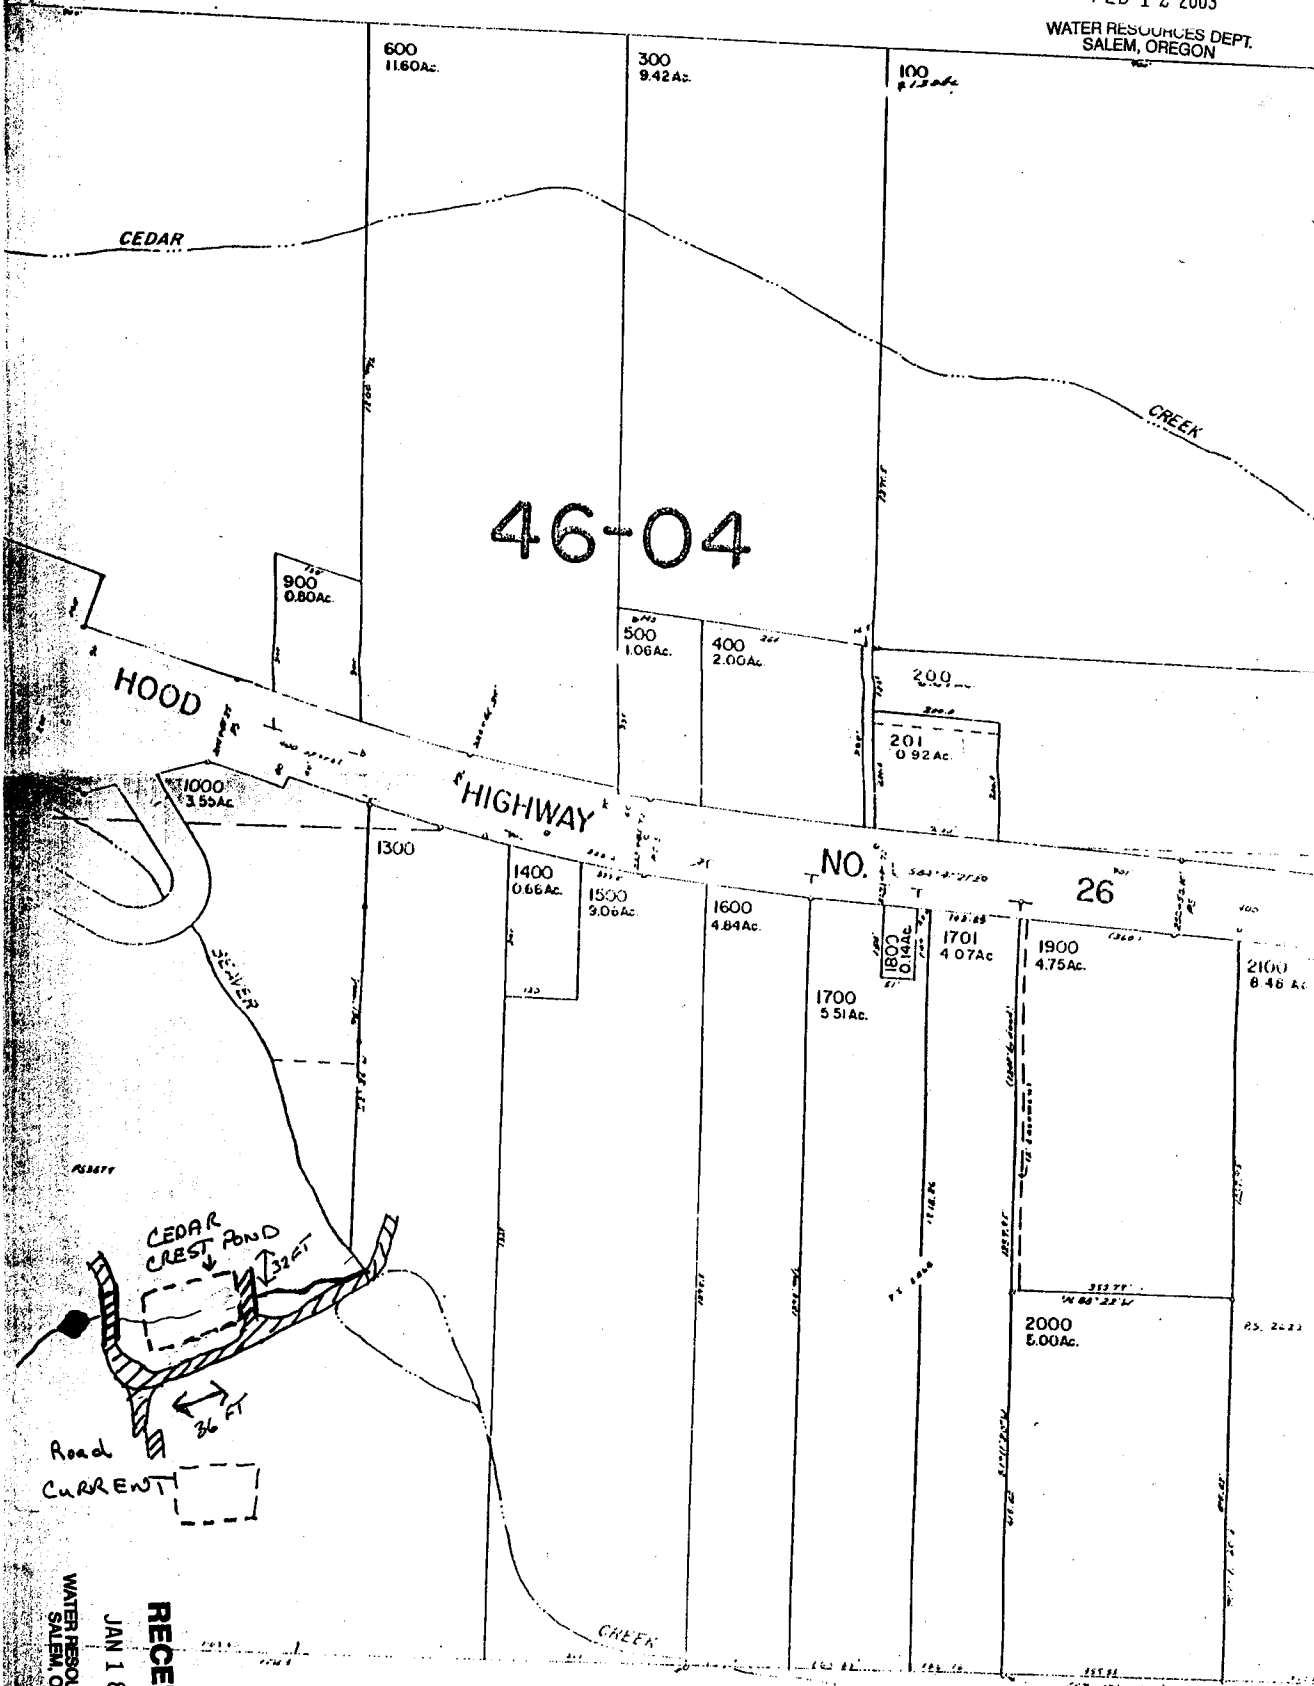

46-04

HOOD

HIGHWAY

NO.

26

CEDAR
CREST POND

Road
CURRENT

RECEIVED

JAN 18 2001

WATER RESOURCES DEPT.
SALEM, OREGON