


RECEIVED

AUG 02 2001

WATER RESOURCES DEPT
SALEM, OREGON

T. 38 S., R. 13 E., W.M.

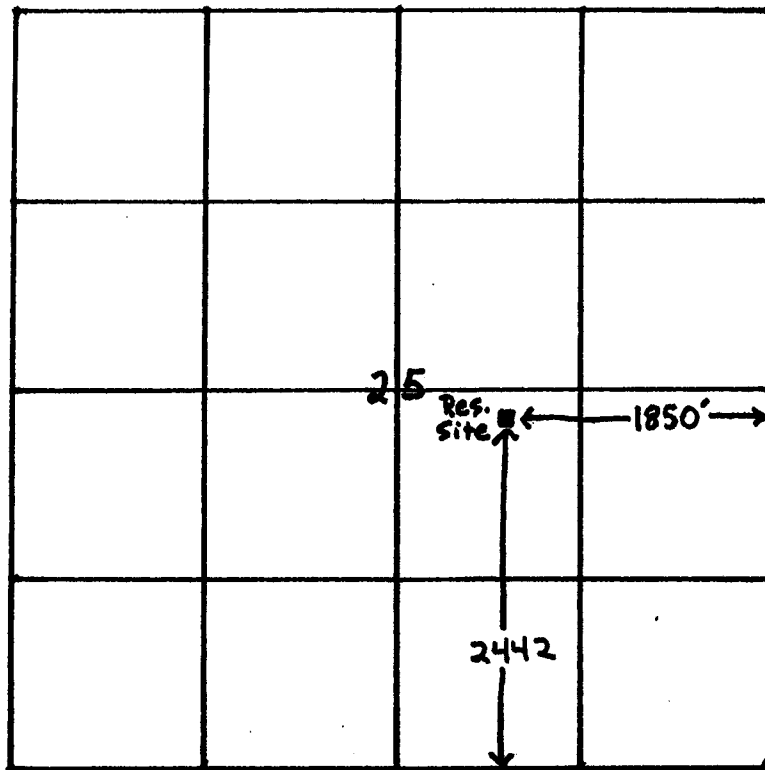

Section
Corner

N
↑

1" = 1320'

Application No. 284827
Permit No. R-13398

RECEIVED

MAY 20 2004

WATER RESOURCES DEPT
SALEM, OREGON

Application Map

For

Paddock Waterhole

In Name Of

United States Bureau of Land Management
Lakeview District

The purpose of this map is for identifying the location of the water right only and is not intended to provide legal dimensions or location of property ownership lines.

Dana J. Fisher
7/31/01