

RECEIVED

AUG 31 2001


WATER RESOURCES DEPT
SALEM, OREGON

COLUMBIA EMPIRE FARMS, Inc
R-2 RANCH POND # 5

T. 9 S., R. 15 E., W.M.

SECTION 36

N

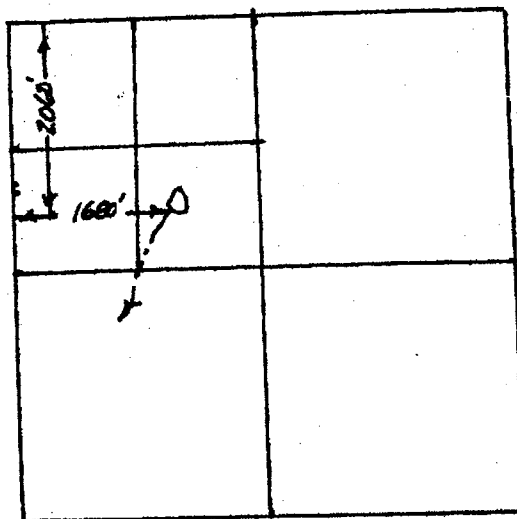

SCALE: 1" = 2000'

Application No.
Permit No.

R84893
R-13265

RECEIVED

AUG 12 2003

WATER RESOURCES DEPT.
SALEM, OREGON