
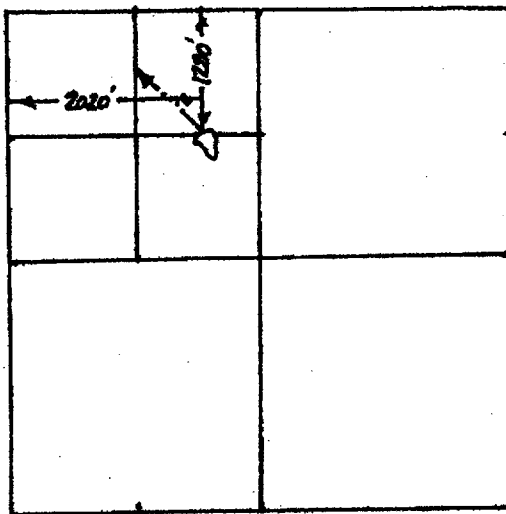


RECEIVED
AUG 3 1 2001
WATER RESOURCES DEPT
SALEM, OREGON

COLUMBIA EMPIRE FARMS, INC
R-2 RANCH POND # 8

T. 9 S., R. 15 E., W.M.

SECTION 22

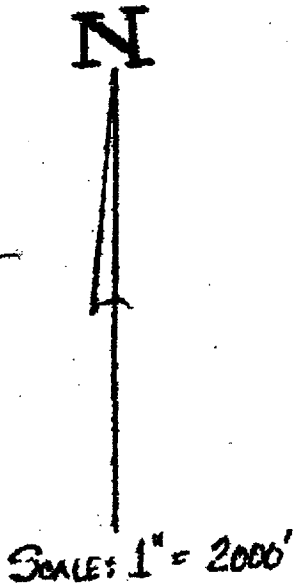

Application No. R 84894
Permit No. R-13266

RECEIVED
AUG 1 2 2003
WATER RESOURCES DEPT.
SALEM, OREGON