
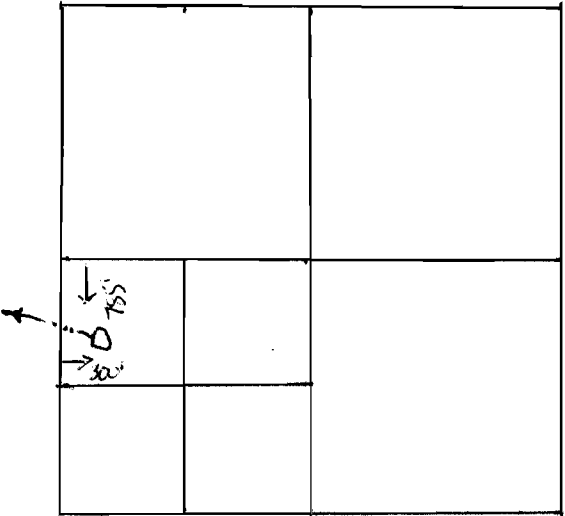


RECEIVED  
AUG 31 2001  
WATER RESOURCES DEPT  
SALEM, OREGON

COLUMBIA EMPIRE FARMS, INC  
R-2 RANCH POND # 17

T. 8 S., R. 15 E., W.M.

SECTION 21

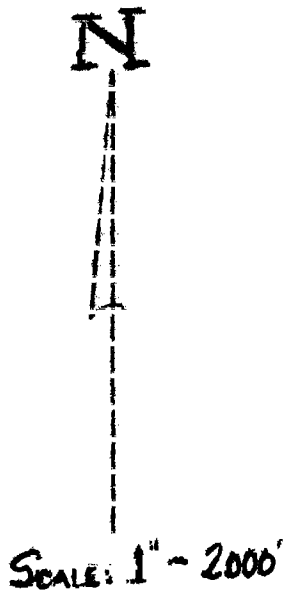

Application No. R 84900  
Permit No. R-13271