
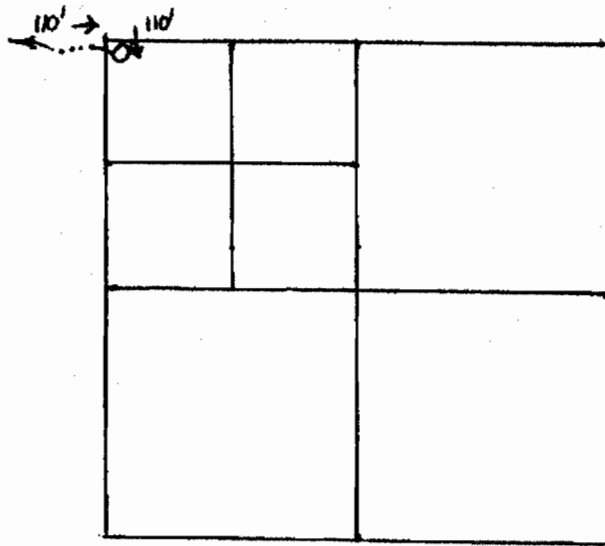


RECEIVED
AUG 31 2001
WATER RESOURCES DEPT
SALEM, OREGON

COLUMBIA EMPIRE FARMS, INC
R-2 RANCH POND # 21

T. 8 S., R. 15 E., W.M.

SECTION 20

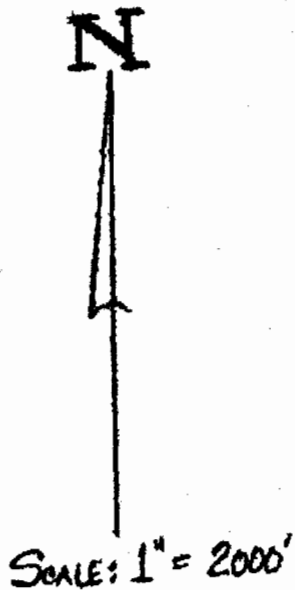

Application No. R 84903
Permit No. R-13274

RECEIVED
AUG 12 2003
WATER RESOURCES DEPT.
SALEM, OREGON