
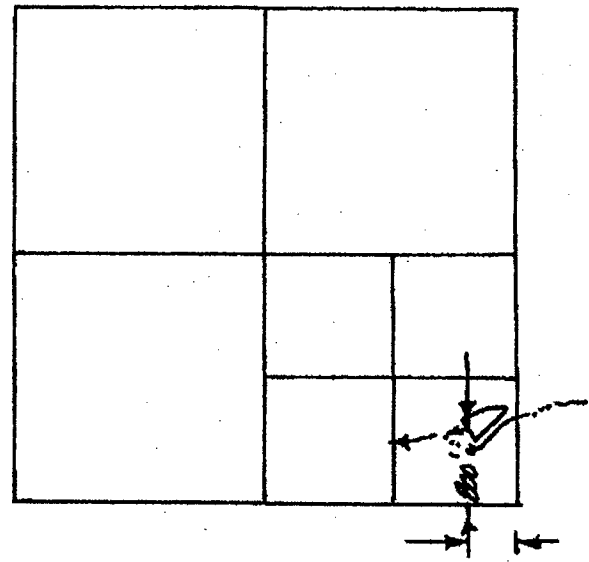


RECEIVED
AUG 31 2001
WATER RESOURCES DEPT.
SALEM, OREGON

COLUMBIA EMPIRE FARMS, INC
R-2 RANCH POND # 22
T. 8 S., R. 15 E., W.M.
SECTION 8

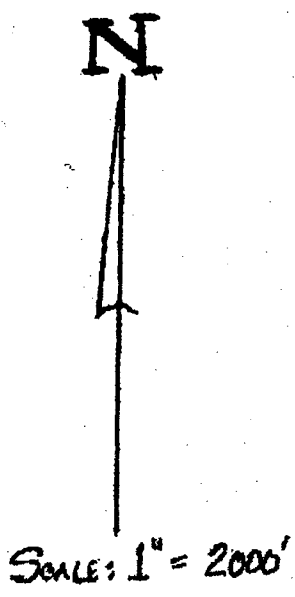

Application No. R 84904
Permit No. R 13275

RECEIVED
AUG 12 2003
WATER RESOURCES DEPT.
SALEM, OREGON