
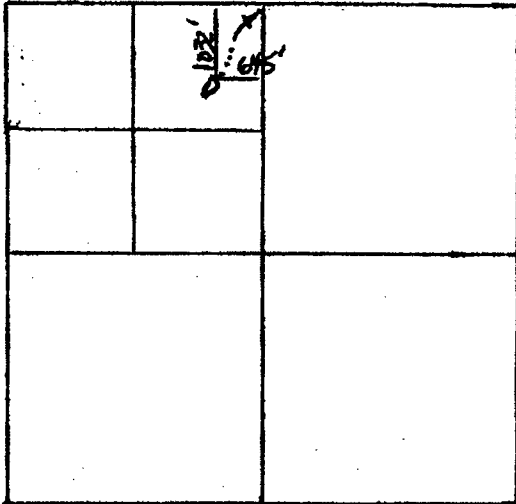


RECEIVED
AUG 31 2001
WATER RESOURCES DEPT
SALEM, OREGON

COLUMBIA EMPIRE FARMS, INC
R-2 RANCH POND # 24
T. 6 S., R. 15 E., W.M.
SECTION 30

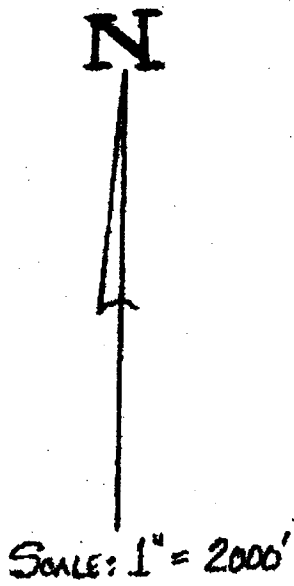

Application No. R84906
Permit No. R-13276

RECEIVED
AUG 12 2003
WATER RESOURCES DEPT.
SALEM, OREGON