
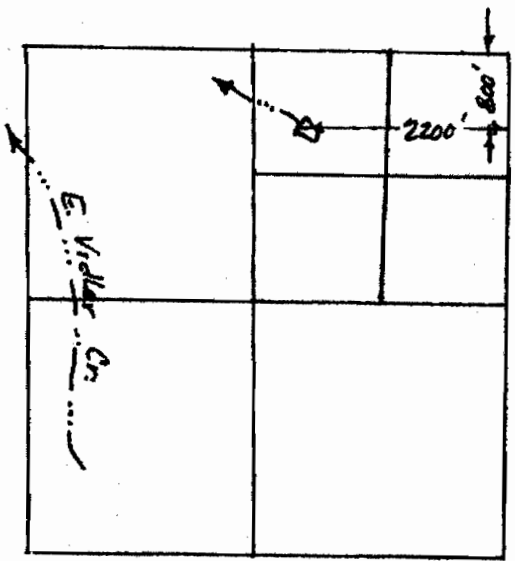


RECEIVED
AUG 31 2001
WATER RESOURCES DEPT.
SALEM, OREGON

COLUMBIA EMPIRE FARMS, INC
R-2 RANCH POND # 28
T. 7 S., R. 15 E., W.M.
SECTION 19

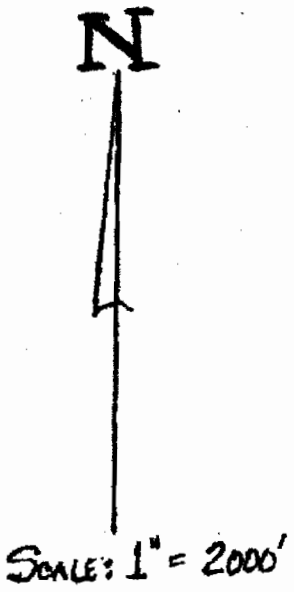

Application No. 284909
Permit No. R-13277

RECEIVED
AUG 12 2003
WATER RESOURCES DEPT.
SALEM, OREGON