

COLUMBIA EMPIRE FARMS, INC  
R-2 RANCH POND # 29


T. 7 S., R. 15 E., W.M.

SECTION 28

N



SCALE: 1" = 2000'

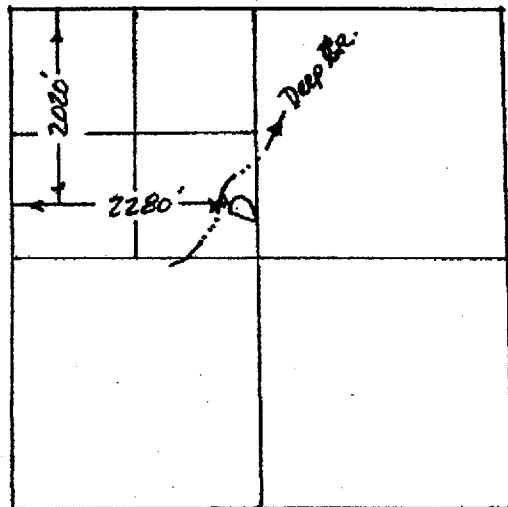

**RECEIVED**

AUG 12 2003

WATER RESOURCES DEPT.  
SALEM, OREGON