


8797

S.E. 1/4 of S.E. 1/4

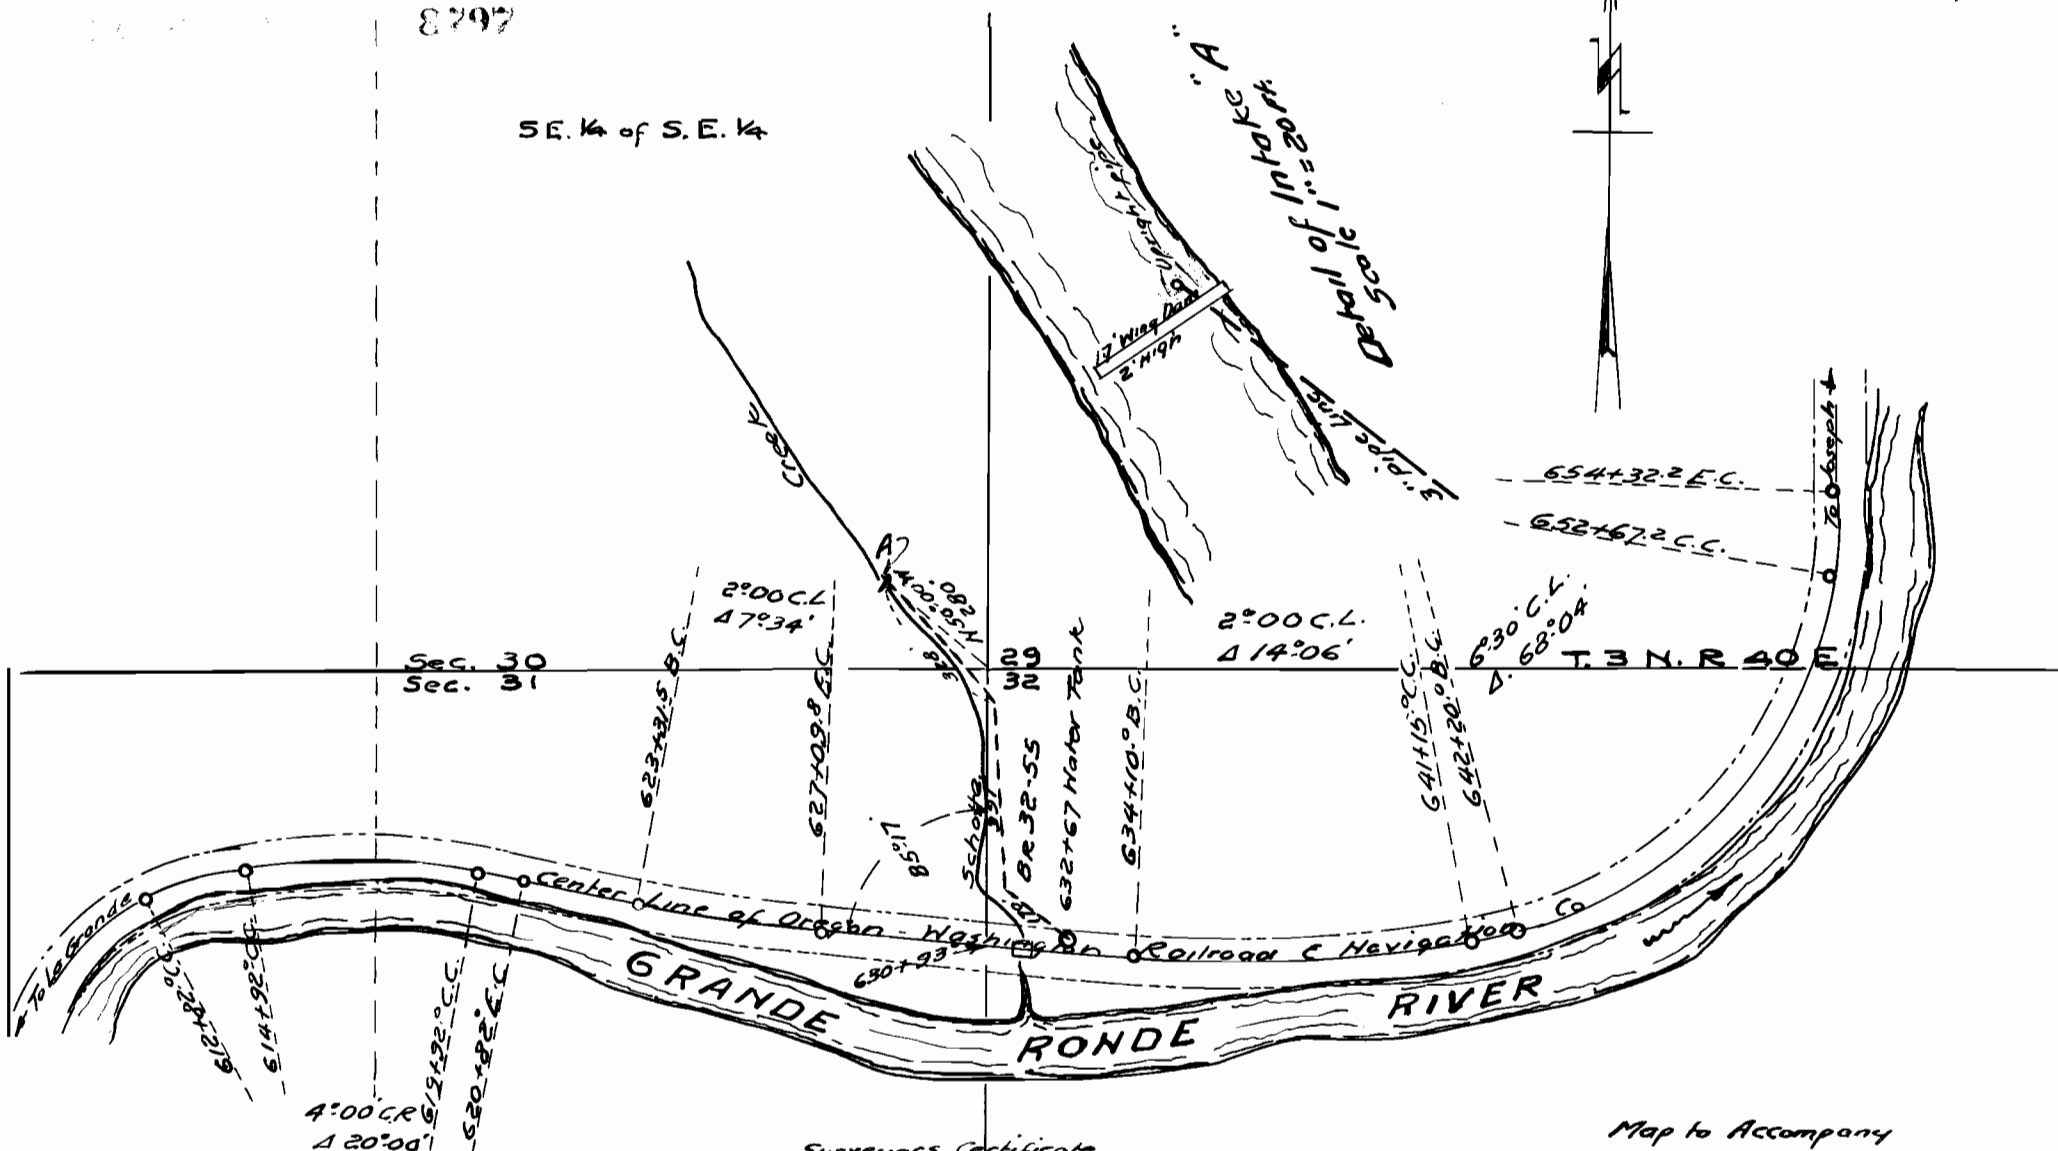

## Surveyors Certificate

State of Oregon }  
 County of Union } S.S. I. R. T. Eaton being first duly sworn, depose and say:  
 That I surveyed the water supply & pipe line of Oregon - Washington Rail-  
 road & Navigation Company at Schotte Creek near Looking Glass station, on  
 its line of Railroad. That I correctly surveyed said water supply and pipe  
 line on the 11th day of Oct. 1928, and the location of same is correctly  
 shown on annexed plat.

Subscribed and sworn to before me, this day of Oct. 13th 1928.  
 My commission expires Aug 26 - 1932 - Oscar Johnson  
 Notary Public for Oregon

Map to Accompany  
 Application for Water Appropriation by  
 O. W. R. R. & N. Co.  
 at Schotte Creek near Looking Glass, Ore.

Off. of Divn. Supt. Second Division  
 La Grande, Ore.

Scale 1"=400'

Oct. 12, 1928

B.D. 2564