


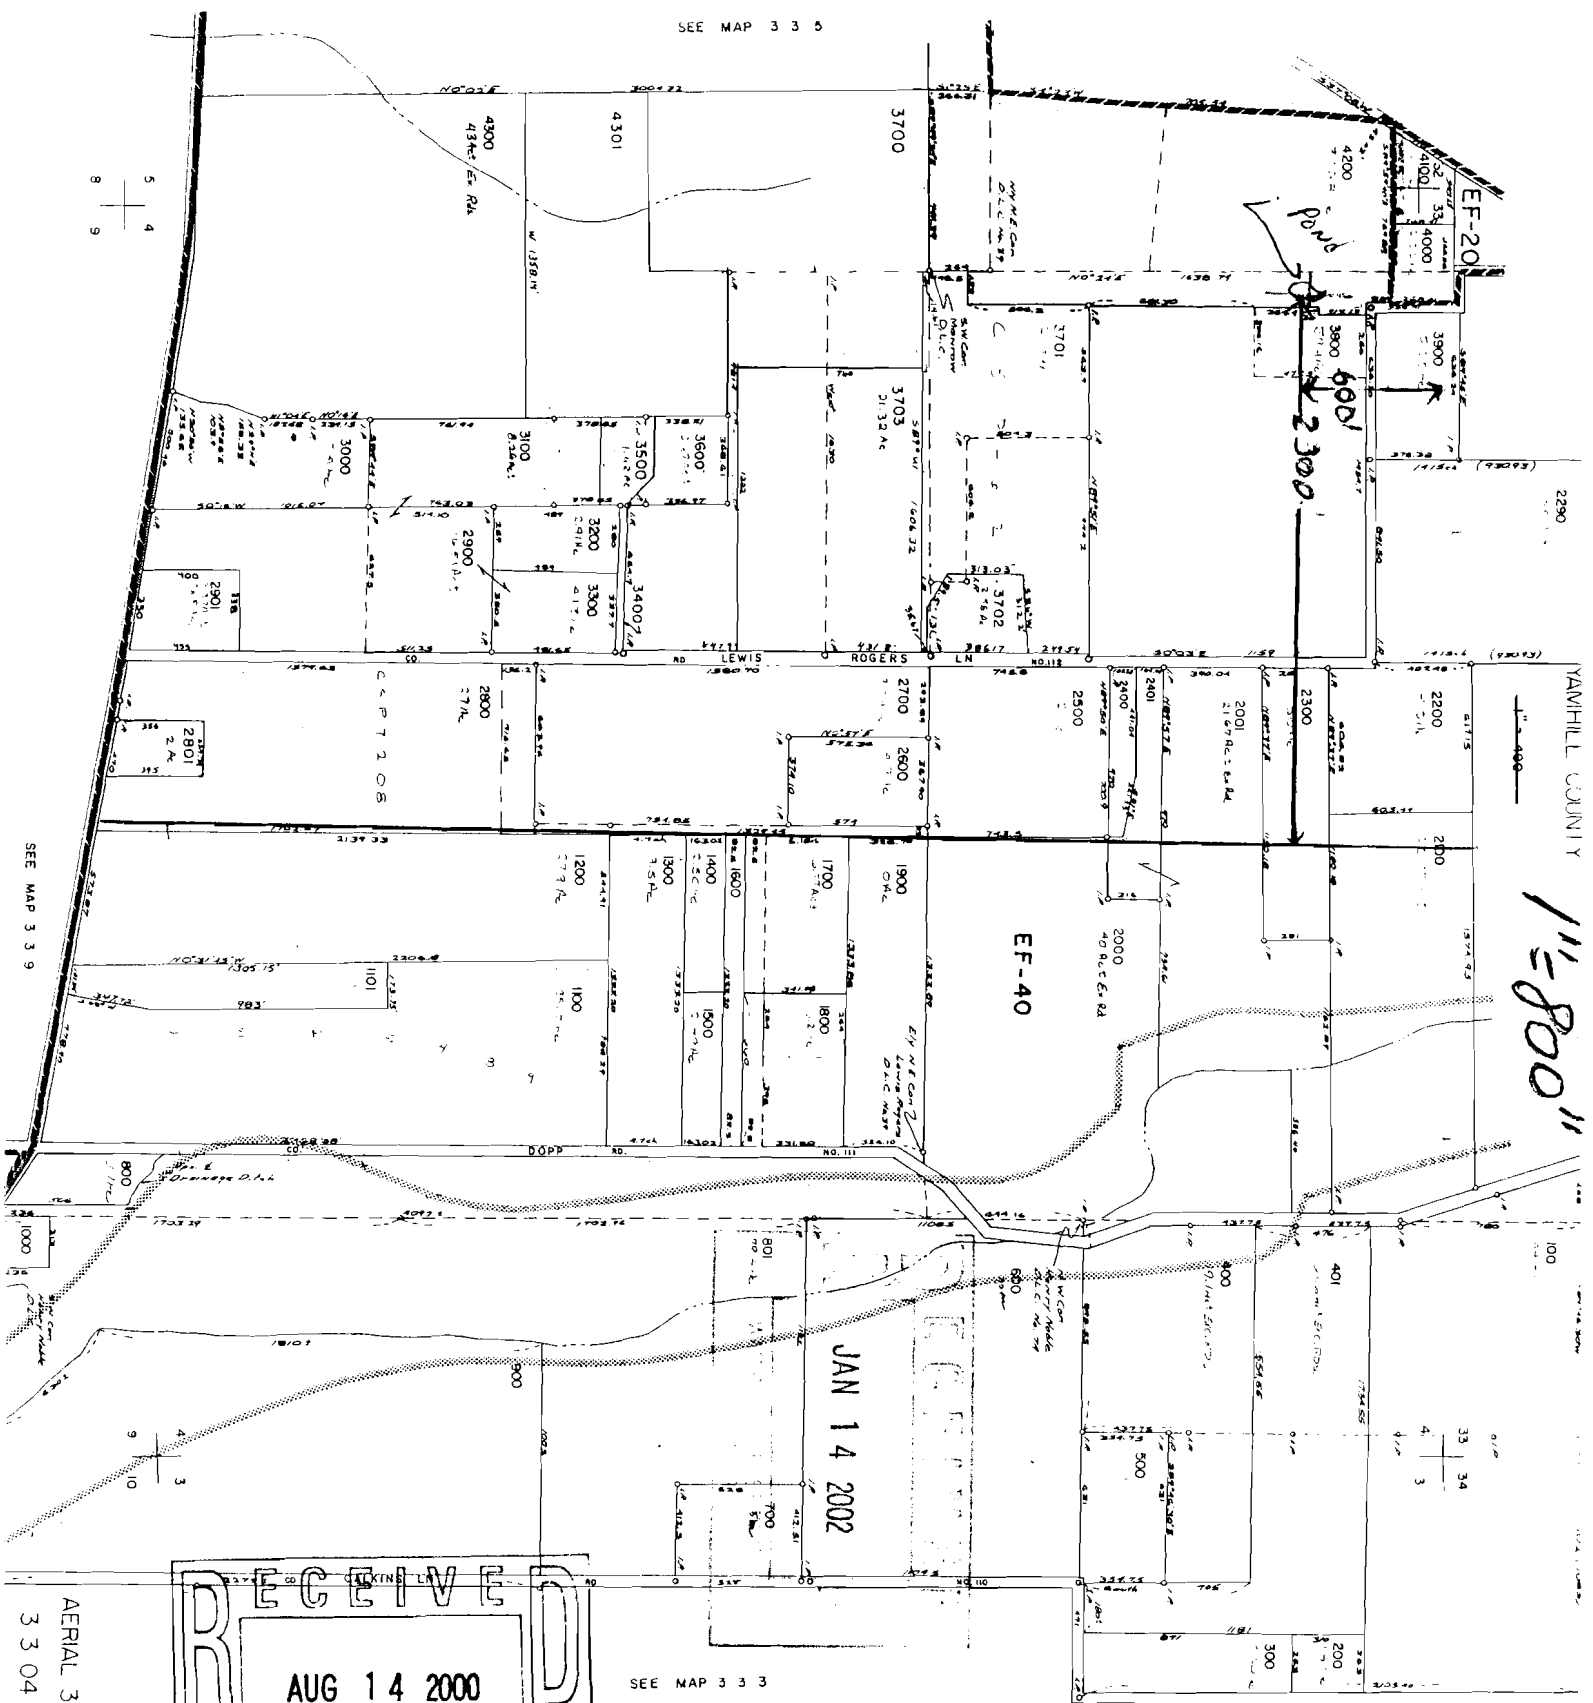

RECEIVED
 AUG 14 2000
 WATER RESOURCES DEPT
 SALEM, OR

Application No. 84504
 Permit No.

LEGEND

Zoning District	City L
Boundary	Bound
Flood Hazard	Urban
Zoning District	Bound
Boundary	
Willamette	Condit
Greenway	Use Pe
Boundary	Bound
	70' SETBACK

Land Use Action	
Tax Lot	Docket
2000, 2001	R.O.C.B.
4301	P-42-87
3500, 3600	Z-6-88
3001, 4301	P-714-77
1701	R.C.B.
2801	P/OU-44-85
3703	R.C.B.
4301	P-10-89

AERIAL 3DD 131
 3 3 04

