



T.8S., R.39E., W.M.

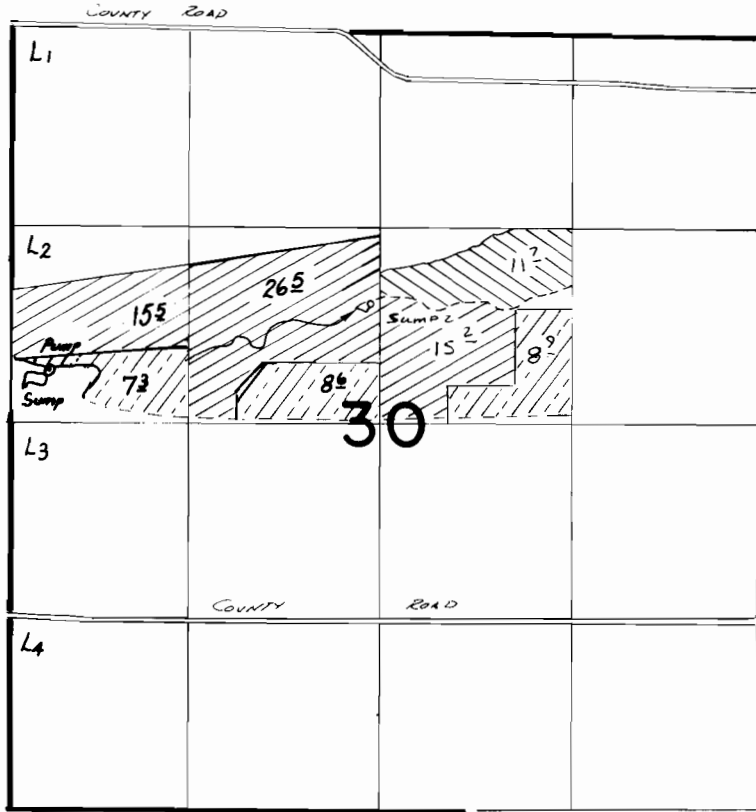

SUMP 1 Loc: 380'N & 270'E. FROM W 1/4 COR. SEC 30
 SUMP 2 Loc: 820'N & 60'W. FROM CENTER COR. SEC 30

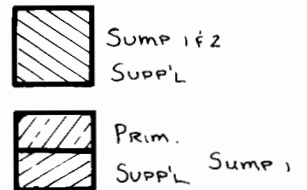

FINAL PROOF SURVEY
 UNDER

Application No. **G:7387** Permit No. **G:6901**
 IN NAME OF

ELVIN E. CARTER

Surveyed *July 13* 19*82*, by *V. L. Church*