


T. 14 S. R. 21 & 22 E. W. M.

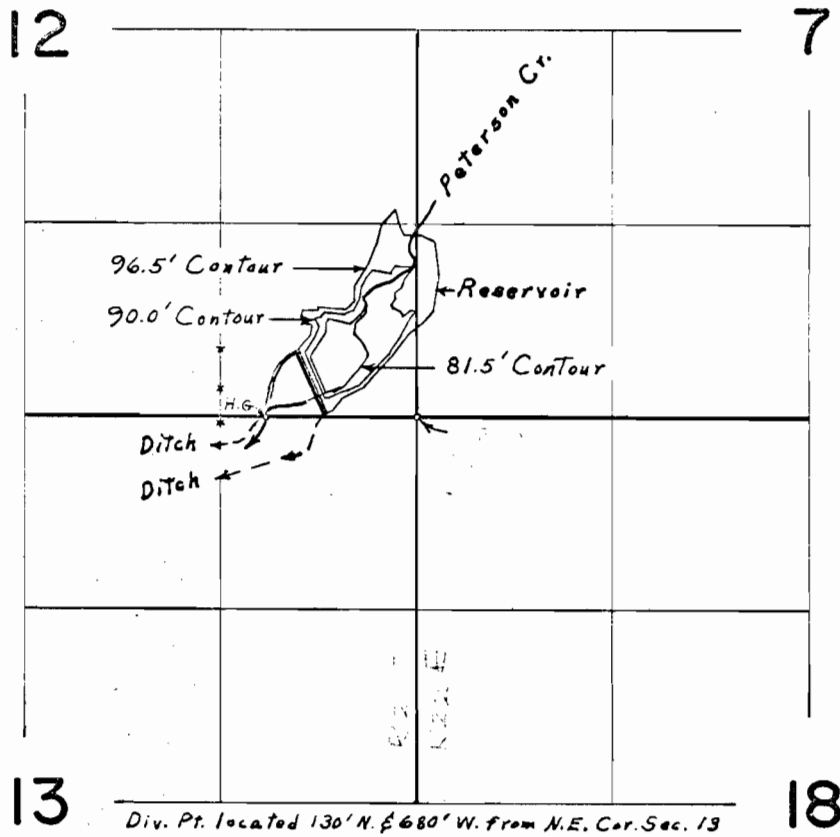

FINAL PROOF SURVEY
UNDER

Application No. R-28664. Permit No. R-1554.
IN NAME OF

.....
Surveyed Oct. 28, 1968, by L. E. Gould.....