


# T. 14 S. R. 21 E. W.M.

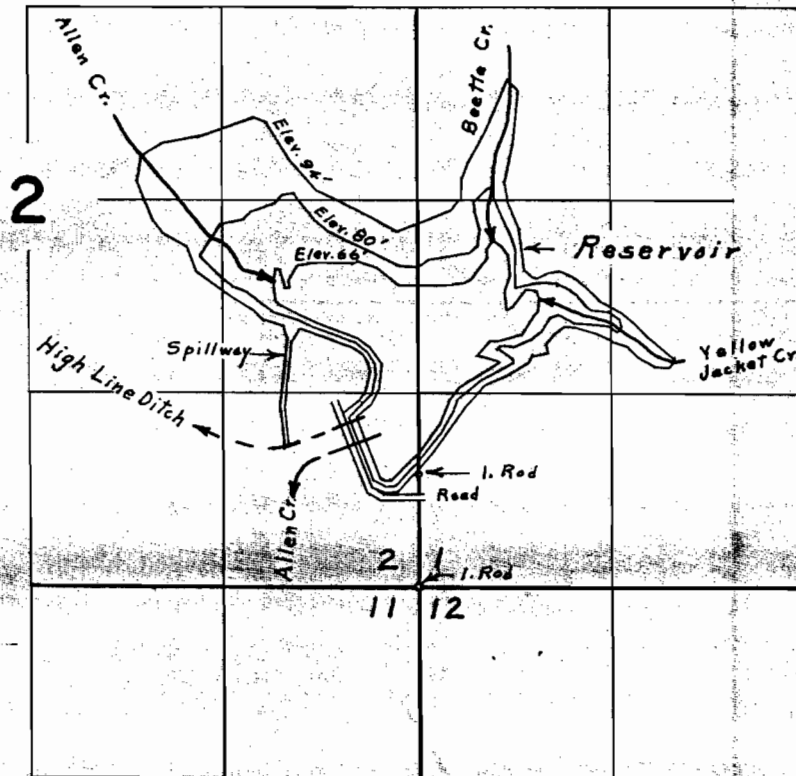

Note: Elevations Crest 100'  
Spillway 94'

## FINAL PROOF SURVEY UNDER

Application No. R-29713 Permit No. R-1710  
R-30753 R-2000  
IN NAME OF

Surveyed Oct. 26, 1968, by L. E. Gould