T.13S. R.12E.W.M.

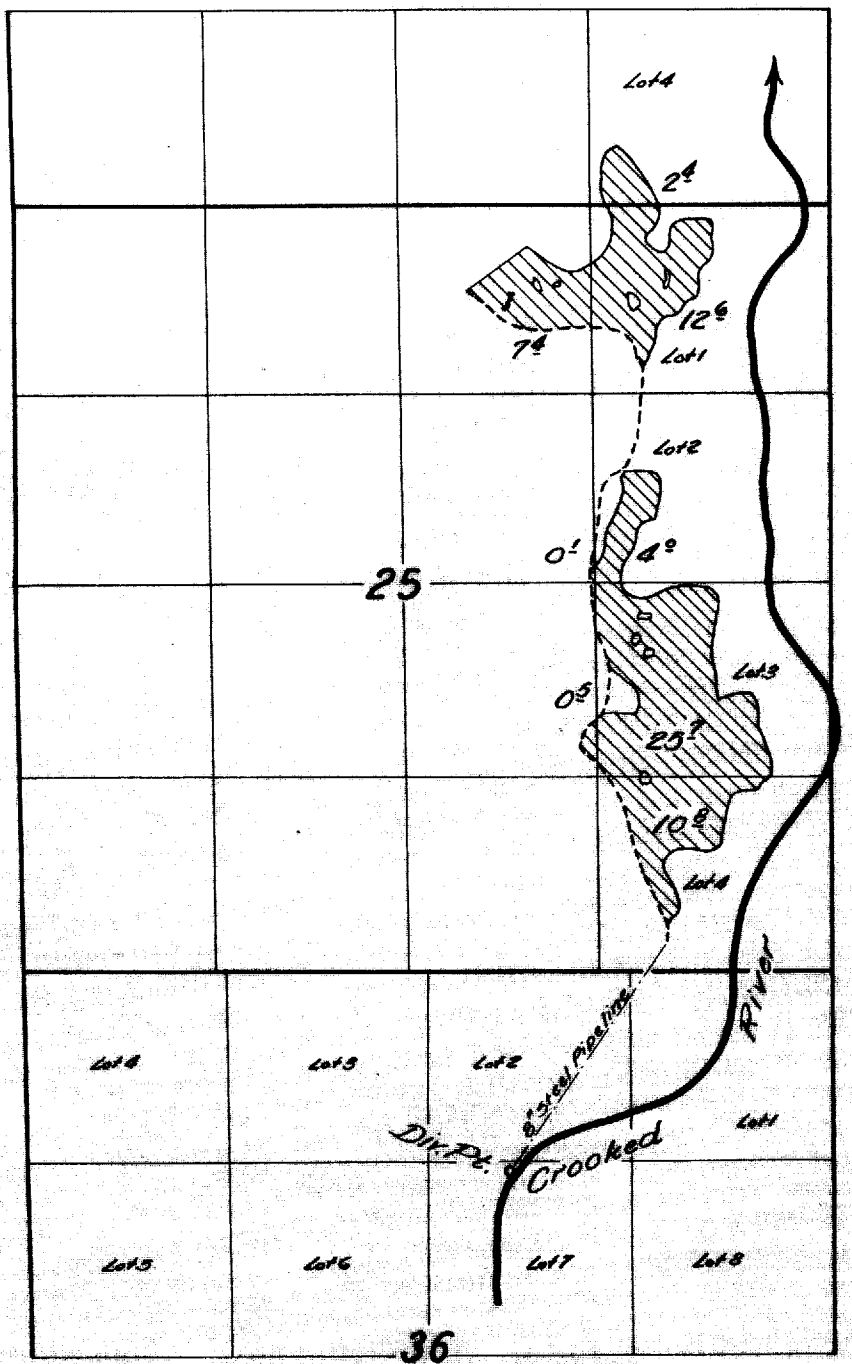

FINAL PROOF SURVEY

UNDER

Application No. 30435 Permit No. 23903

IN NAME OF

C.R. Yunker

Surveyed June 12 1959., by C.A. Bartlett

DOW-SW-208