


T. 6 S. R. 1 W. W. M.

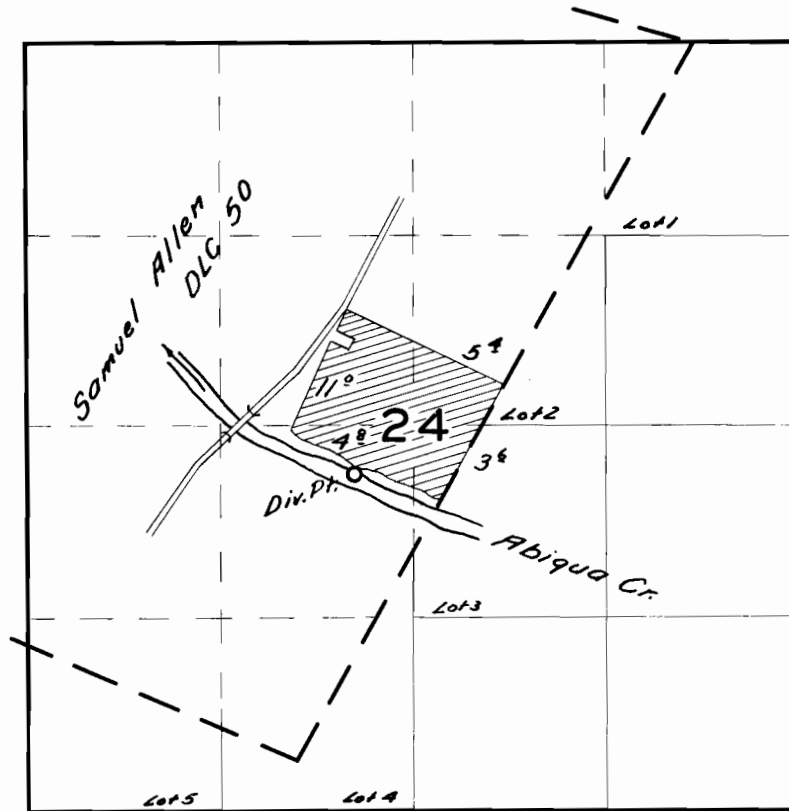

FINAL PROOF SURVEY

UNDER

Application No. 28287 .. Permit No. 22241...

IN NAME OF

William & Lottie DeLough

Surveyed *May 22, 1956*, by *C.O. Bartels*