


T. 26S., R. 3W., W.M.

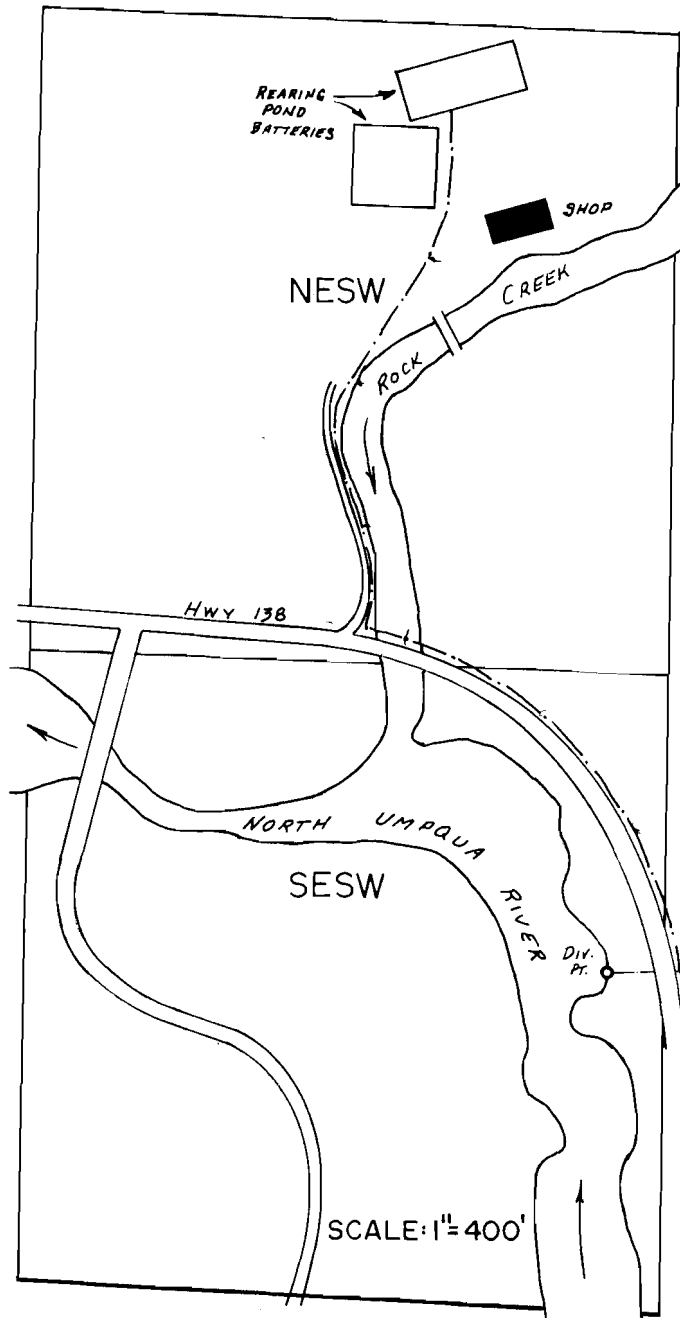

Div. Pt. Loc.: 195 S. & 110' W. FROM C. 1/4 COR. SEC. 1. (A. # 54881)
DIAMOND LAKE DIV. LOC.: 150' N. & 250' E. FROM SW COR.
SEC. 30, T. 27S., R. 6 E., W.M. (A. # 57861)

FINAL PROOF SURVEY
UNDER

57861 43627
Application No. 54881... Permit No. 41447.....
IN NAME OF

OREGON DEPARTMENT OF FISH & WILDLIFE

Surveyed JAN. 22. 19.80, by J.S. DONALDSON