



Final Proof Survey

TOWNSHIP 12 SOUTH RANGE 1 WEST, W.M.

SCALE 1" = 1320 FT.

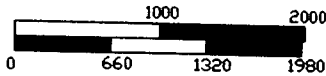

PREPARED BY
Walter L. Trimmer
 CWRE#332
 9/7/2003

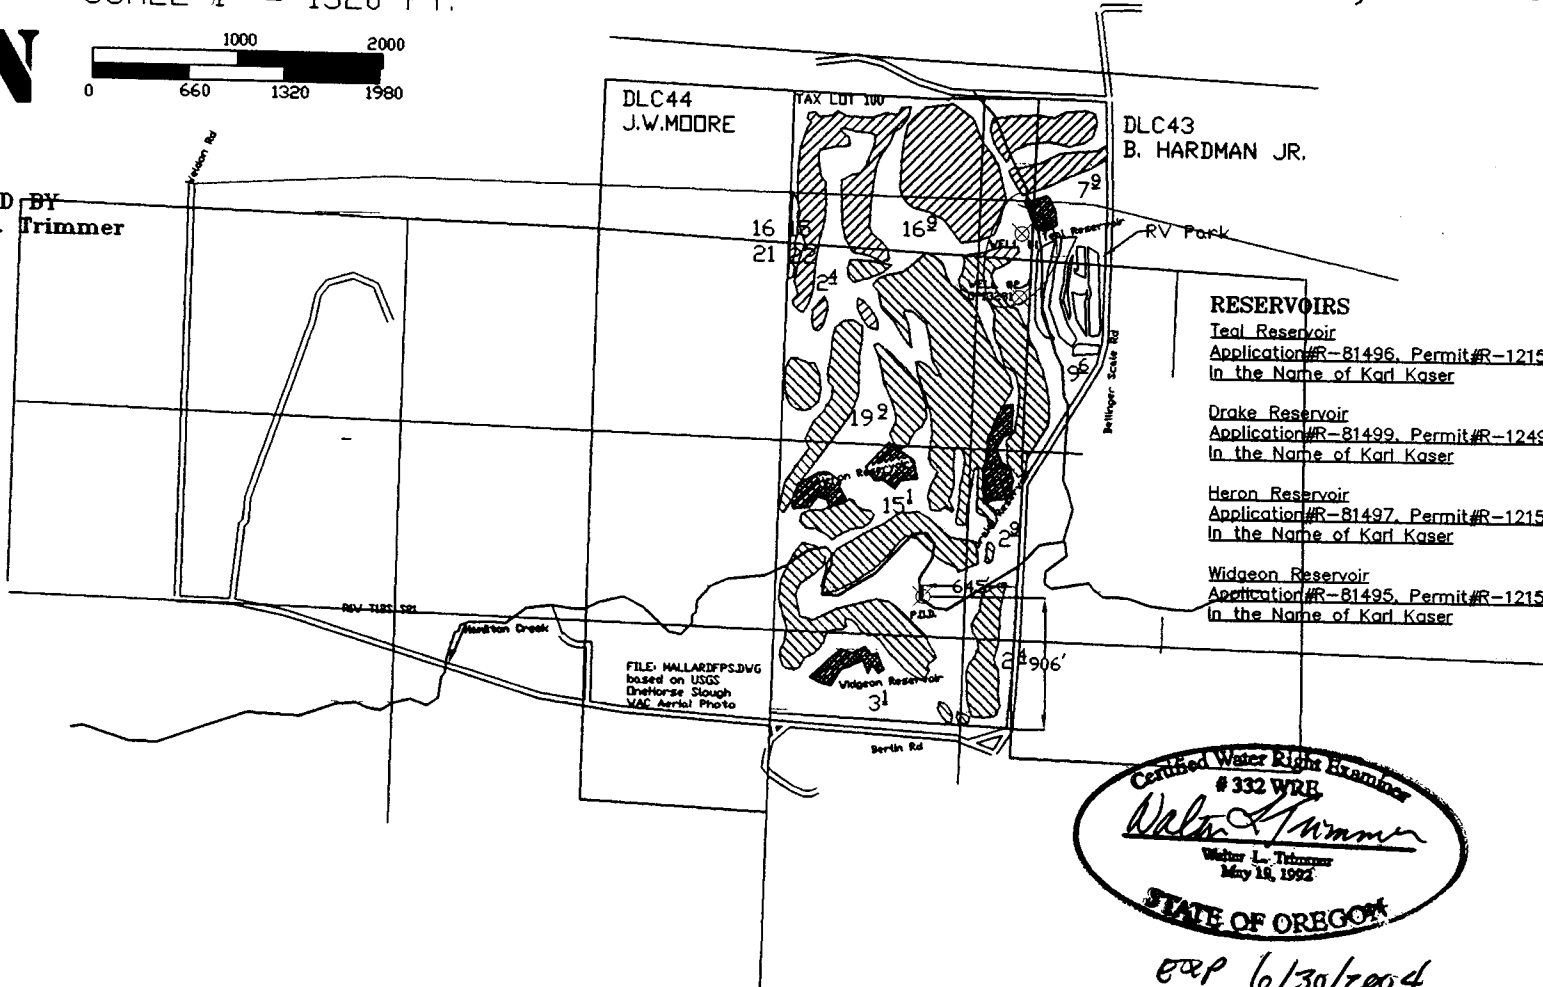

- RESERVOIRS**
- Teal Reservoir
 Application#R-81496, Permit#R-12156
 in the Name of Karl Kaser
 - Drake Reservoir
 Application#R-81499, Permit#R-12492
 in the Name of Karl Kaser
 - Heron Reservoir
 Application#R-81497, Permit#R-12157
 in the Name of Karl Kaser
 - Widgeon Reservoir
 Application#R-81495, Permit#R-12155
 in the Name of Karl Kaser

Certified Water Right Examiner
 # 332 WRR
Walter L. Trimmer
 Walter L. Trimmer
 May 18, 1992
 STATE OF OREGON

exp 6/30/2004

RECEIVED

SEP 15 2003

WATER RESOURCES DEPT.
 SALEM, OREGON