

RECEIVED

MAP TO ACCOMPANY WATER RIGHT TRANSFER APPLICATION FOR
CHANGE IN POINT OF DIVERSION
FOR

JUN 28 2004


WATER RESOURCES DEPT
SALEM, OREGON

Richard K. Defreez & Toni J. Kristensen
T.33S. R.5W.W.M.

RECEIVED

JUN 01 2004

WATER RESOURCES DEPT
SALEM, OREGON

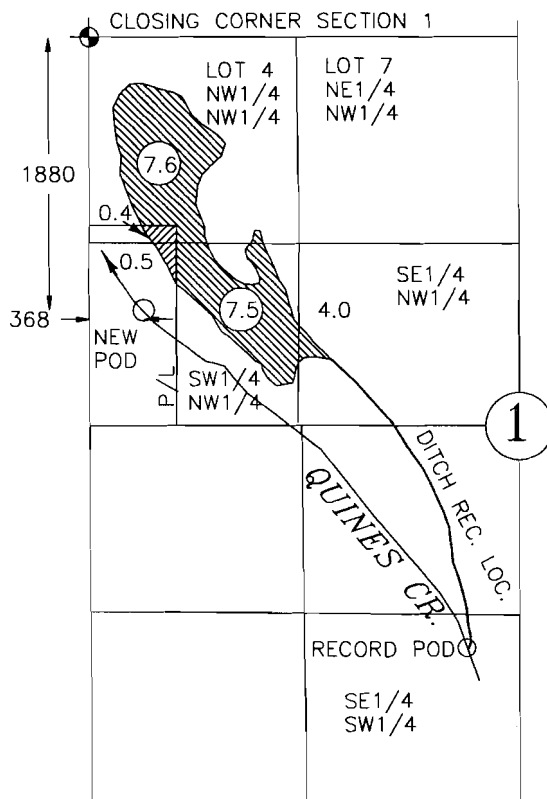

POD SURVEY TIED TO
NE PROPERTY CORNER
AND CALCULATED TO
CLOSING CORNER SECTION
1 FROM SURVEY M142-66
AND LP 1993-0078
OF DOUGLAS COUNTY
SURVEY RECORDS.



AREA THIS
TRANSFER




AREA NOT
INCLUDED IN
THIS TRANSFER

SCALE 1"=1320'

PRESENT P.O.D. FOR
REMAINING LAND.
RECORD LOCATION
IN SE1/4, SW1/4,
SECTION 1,
T35S, R5W, WM

EXISTING WATER RIGHT
PERMIT NO. 10099
CERT. NO. 9798
IN NAME OF C.O. & W. B. GARRETT

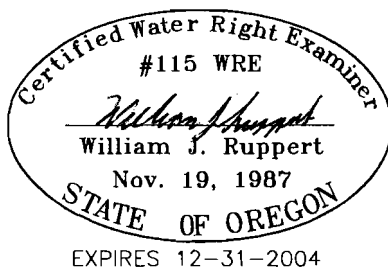

BY: WILLIAM J. RUPPERT
P.O. BOX 1564
MYRTLE CREEK, OR 97457

NOV. 2003

T-9755

THIS MAP IS TO BE USED FOR WATER RIGHT PURPOSES ONLY