



T.33S. R.18E. W.M.

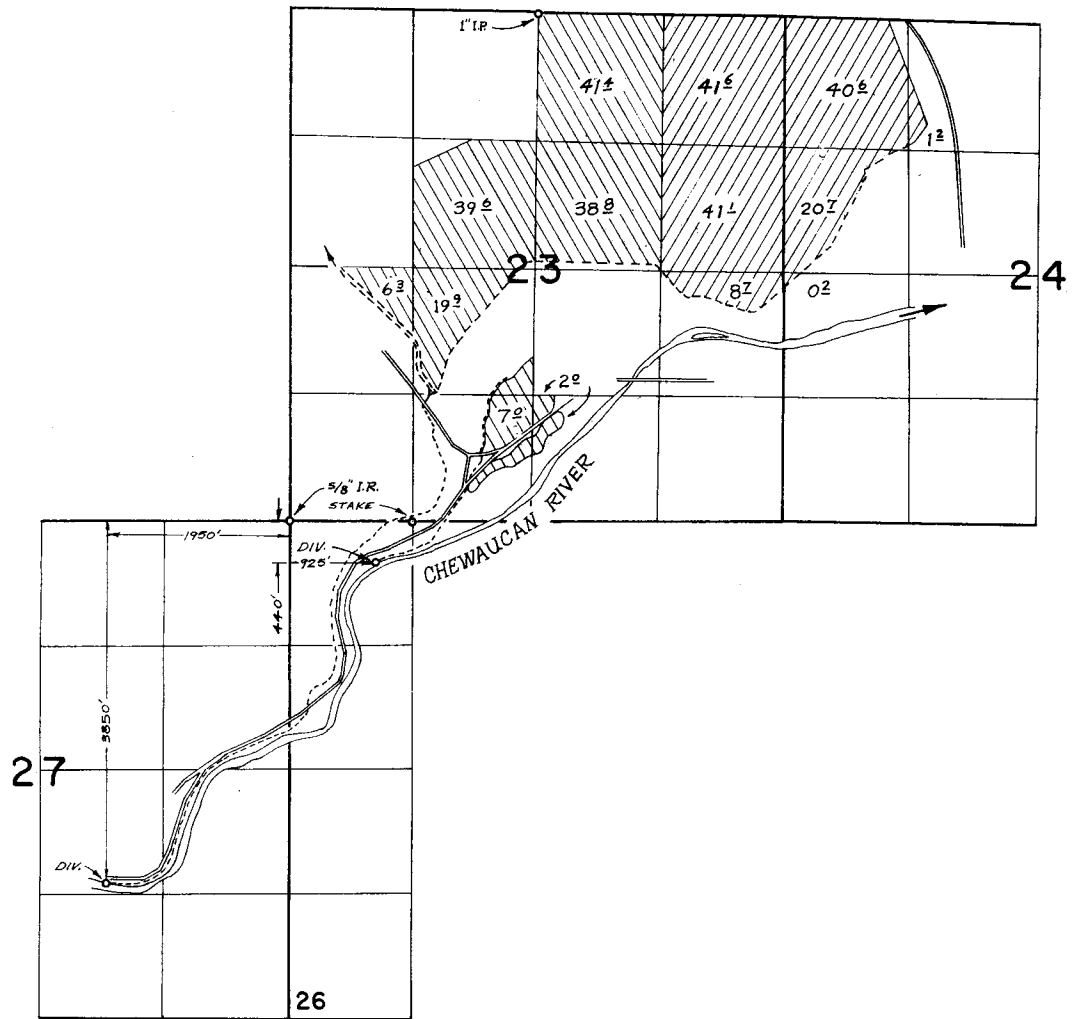

FINAL PROOF SURVEY

UNDER  
 Application No. <sup>12235</sup> 39810 ..... Permit No. <sup>31344</sup> 29821 .....

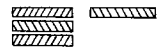

IN NAME OF

ROSS H. & DORIS COLAHAN

Surveyed AUGUST 29 1973, by R. MUCKEN