



T.33S. R.18E. W.M.

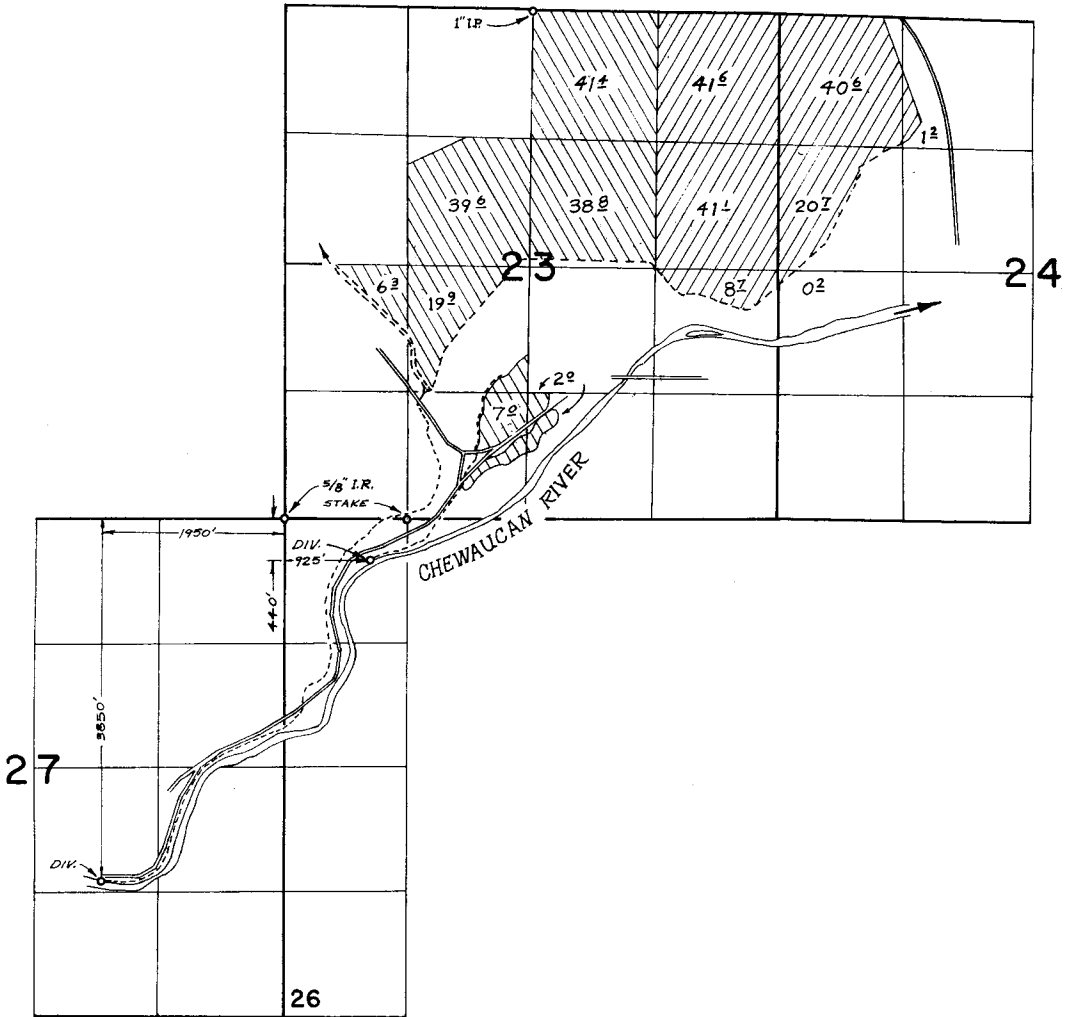

FINAL PROOF SURVEY

UNDER
 12239
 42542
 38810
 Application No. 12239... Permit No. 31344
 31325
 29821

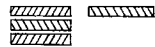

IN NAME OF

ROSS H. & DORIS COLAHAN

Surveyed AUGUST 29 1973, by R. MUCKEN