

RECEIVED

JUN 12 1996

DEPT. OF REVENUE
STATE OF OREGON

RECEIVED

JUL 24 2002

WATER RESOURCES DEPT.
SALEM, OREGON


SCALE 1:9600



THIS MAP WAS PREPARED FOR
ASSESSMENT PURPOSE ONLY

SECTION 16 T15-R38E W.M.
UNION COUNTY

SCALE Annex 1' = 800'

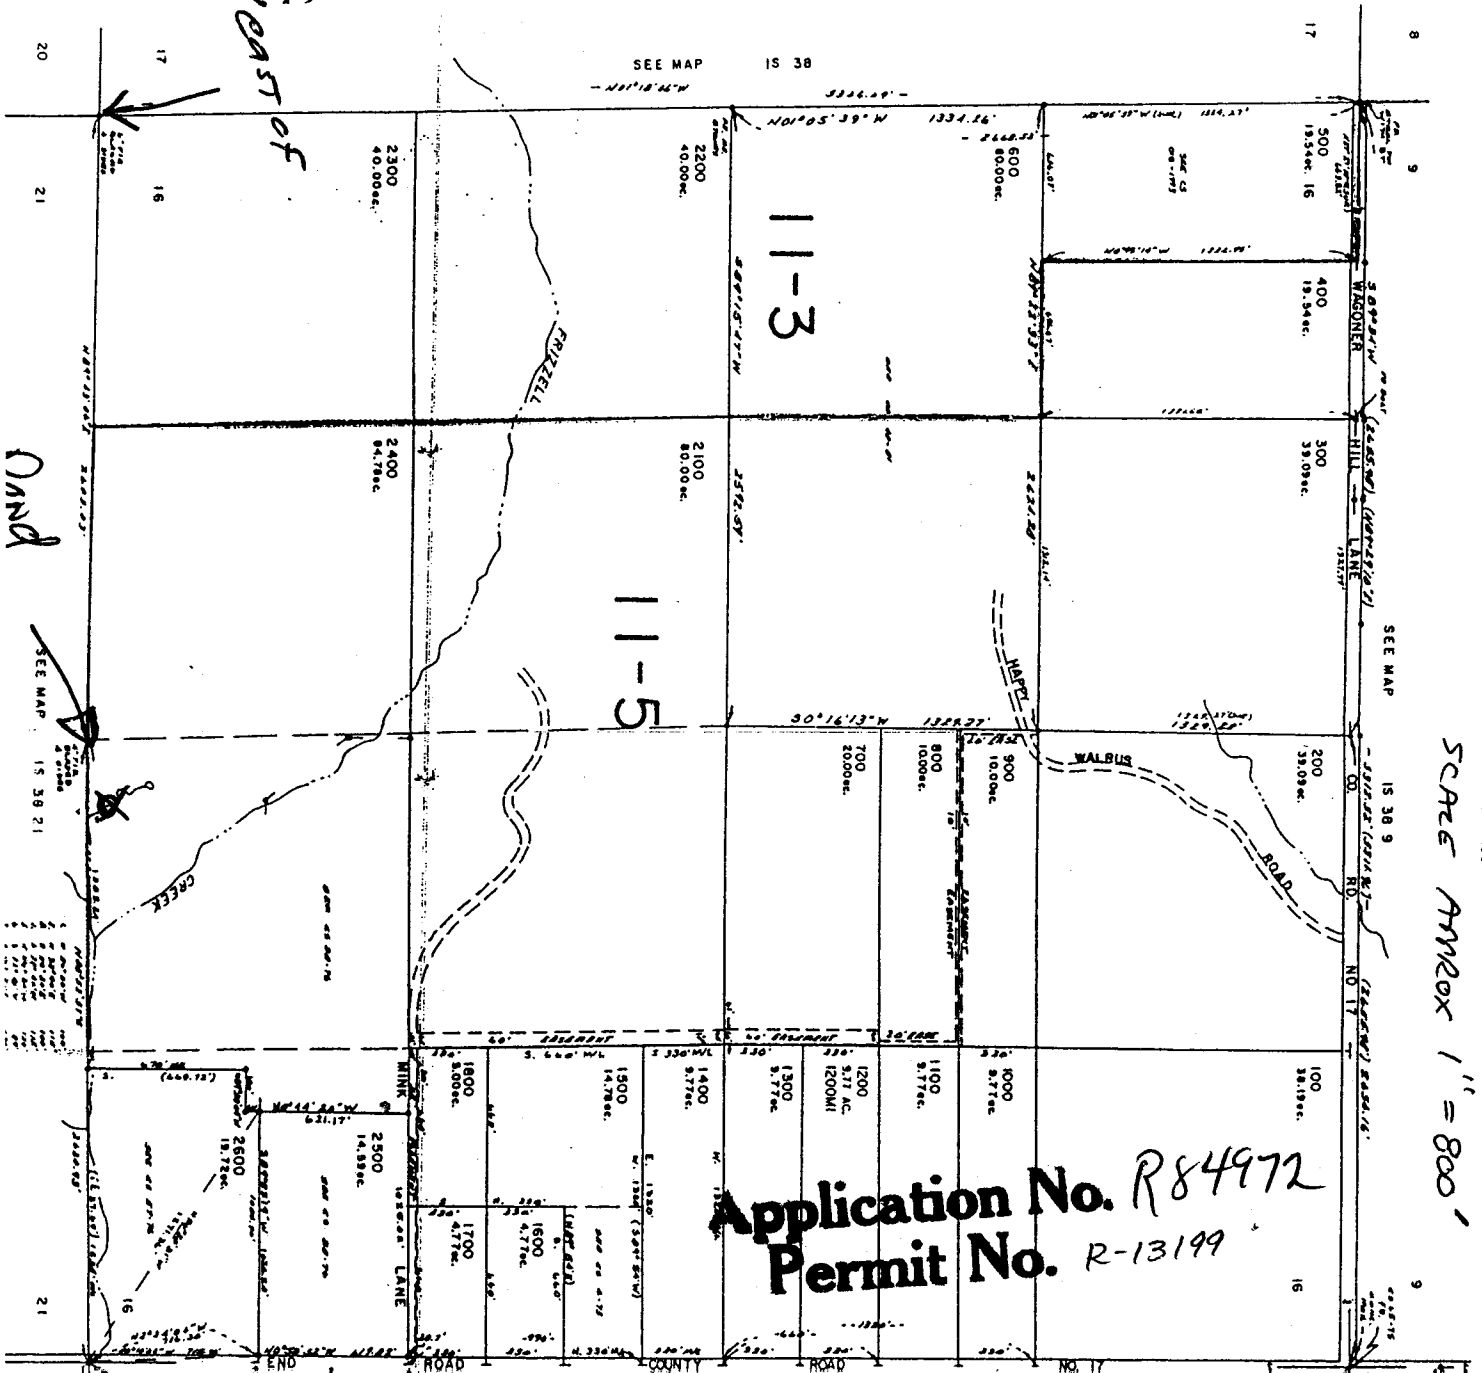

Application No. R84972
Permit No. R-13199

LOCATION of Pond:

DISTANCES TAKEN
FROM COMMON
SECTION CORNERS:
16, 17, 20, 21

80 FT. NORTH
2900 FT. EAST

N
4

CANCELLED NO.
1500 2000

38 16

RECEIVED
NOV 26 2001
WATER RESOURCES DEPT.
SALEM, OREGON