


T. 1 N. R. 4 W. W.M.

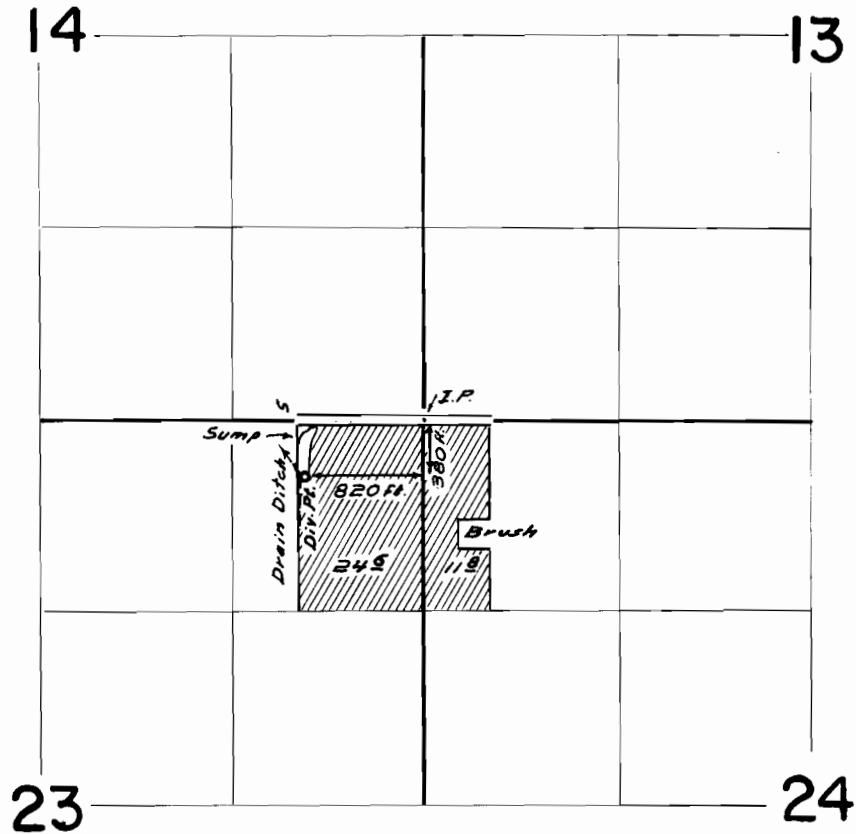

FINAL PROOF SURVEY
UNDER

Application No. 37980 Permit No. 20373
IN NAME OF

Vernon E. Duyck

Surveyed Aug 23, 1966, by W.V. Ruppert