


# T. 1 N. R. 4 W. W. M.

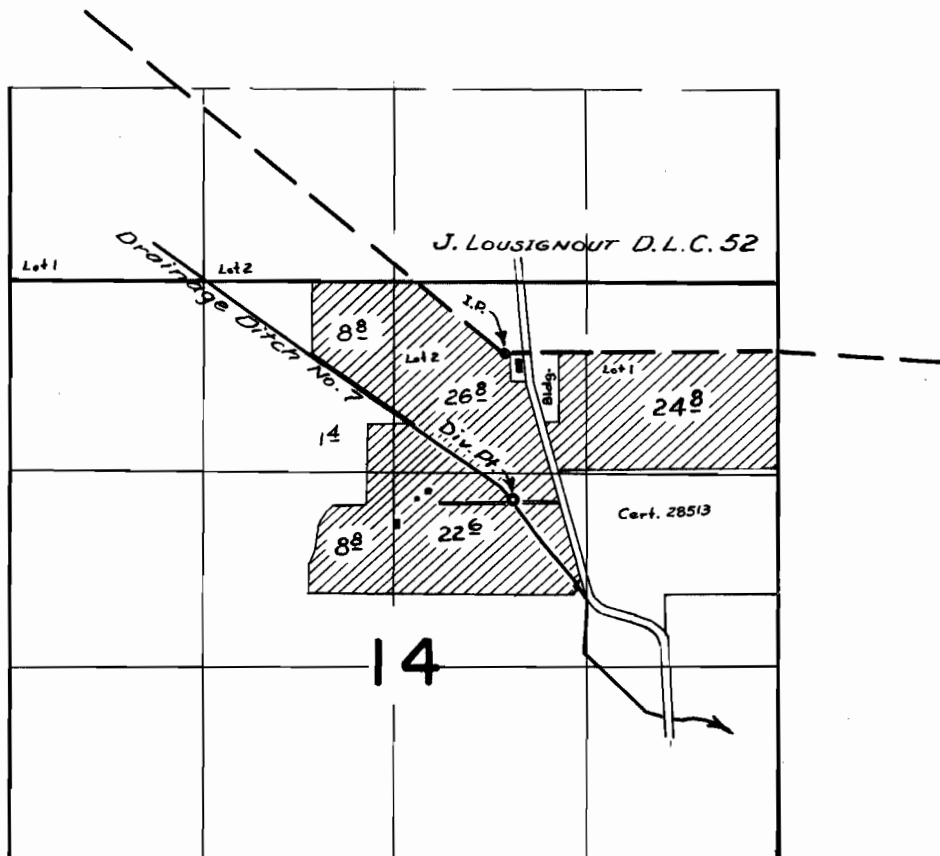

## FINAL PROOF SURVEY UNDER

Application No. 33388 Permit No. 26383  
IN NAME OF

MELVIN L. LOVE

Surveyed MAR. 28 1963, by M. Bish