


T. 1 N. R. 3 W. W. M.

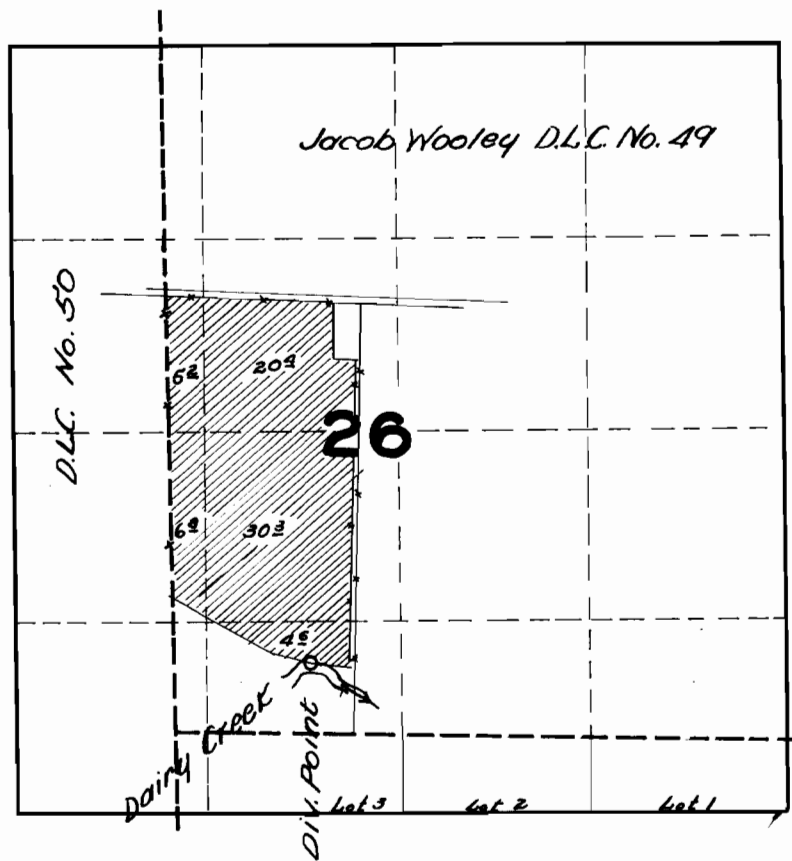

FINAL PROOF SURVEY

UNDER

Application No. 21273 Permit No. 16670
IN NAME OF

RAYMOND HERTEL

Surveyed 8/1 1951, by H.L. COFFMAN