


T. 1 N. R. 3 W. W. M.

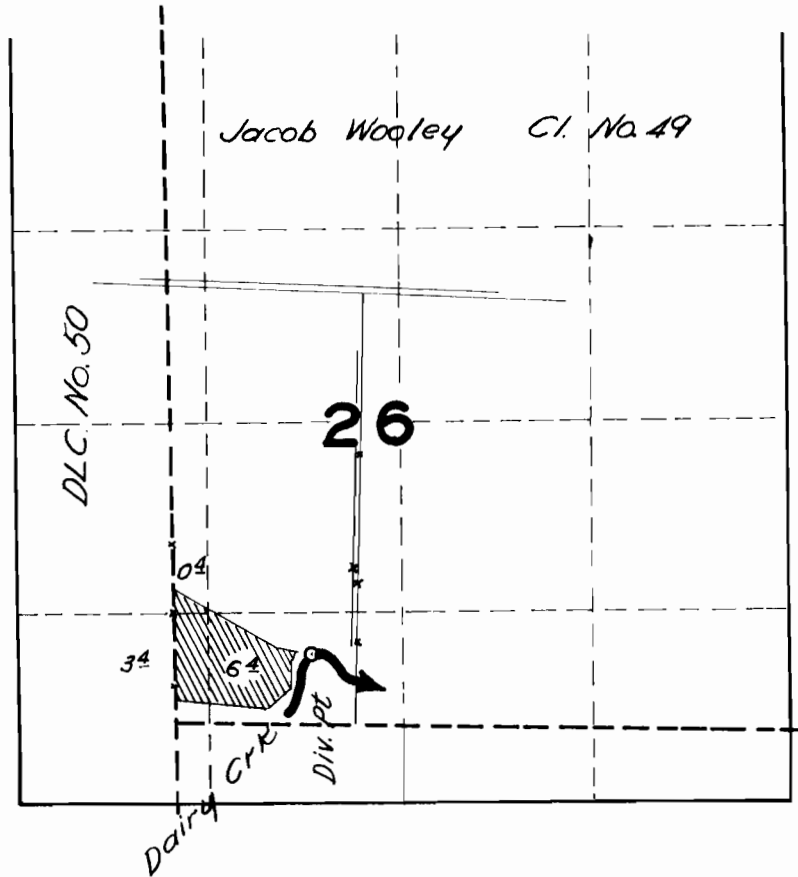

FINAL PROOF SURVEY

UNDER

Application No. 23578 Permit No. 18603

IN NAME OF

RAYMOND BERTEL

Surveyed June 2, 1952, by H. L. COFFMAN