


T. 1 N., R. 3 W., W. M.

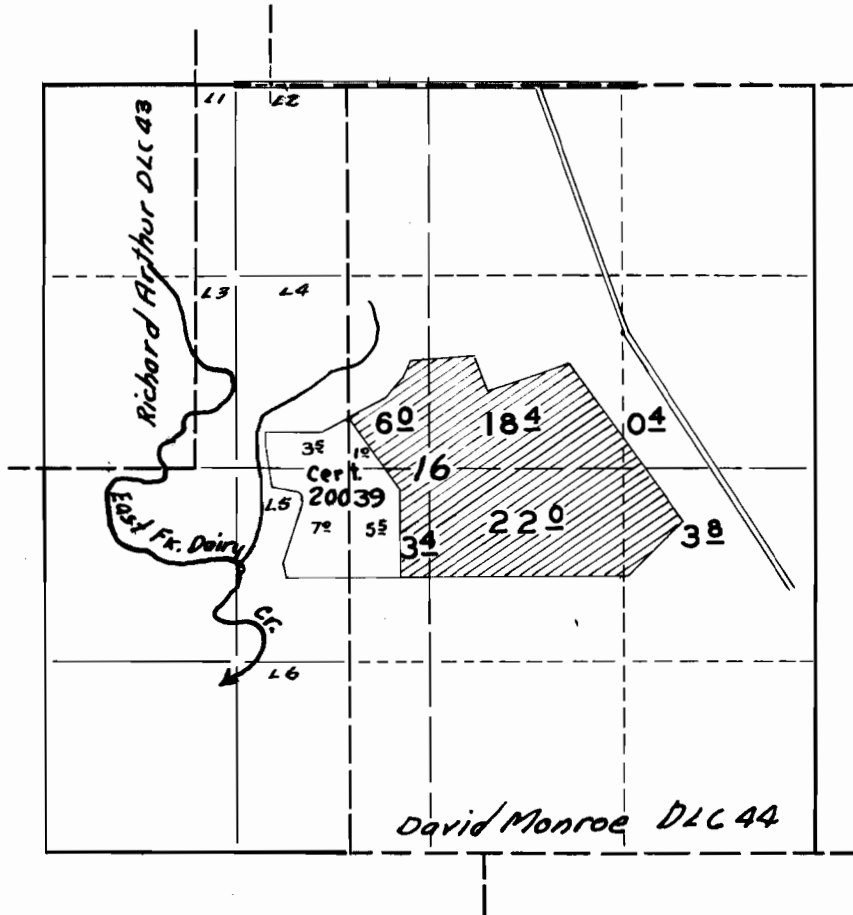

**FINAL PROOF SURVEY**

UNDER

Application No. 25588 Permit No. 20083  
IN NAME OF

ORVILLE SAHNOW

Surveyed 4 - 17 1956, by R. H. WHITBY.