


# T. 1 N. R. 4 W. W. M.

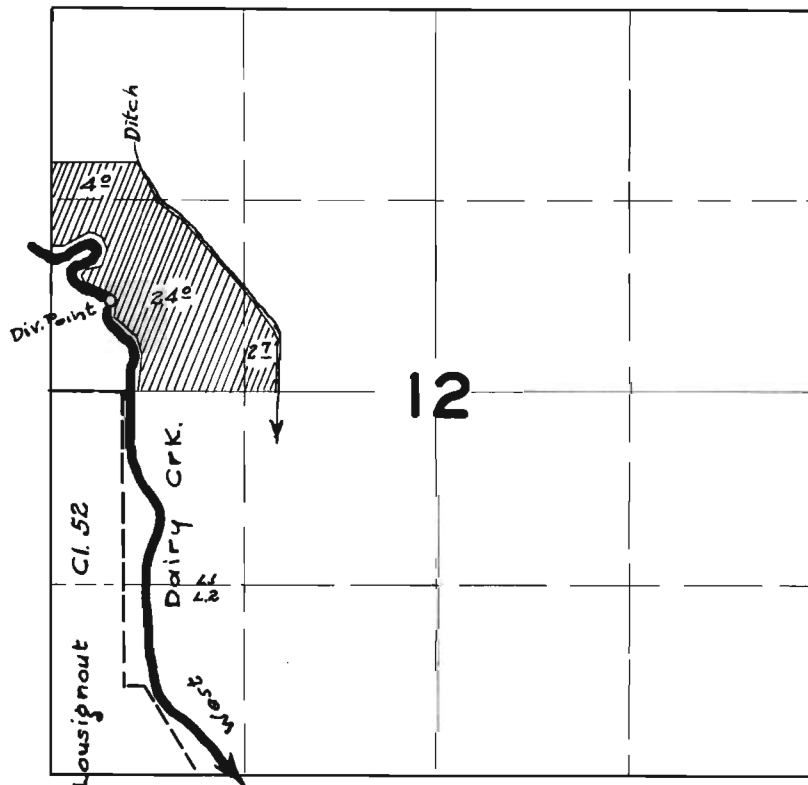

John Lousignout

## FINAL PROOF SURVEY

UNDER

Application No. 22377 Permit No. 17643

IN NAME OF

WILLIAM SUSBAUER

Surveyed 4 / 24 19 52, by H. L. COFFMAN