


T. 1 N., R. 4 W., W.M.

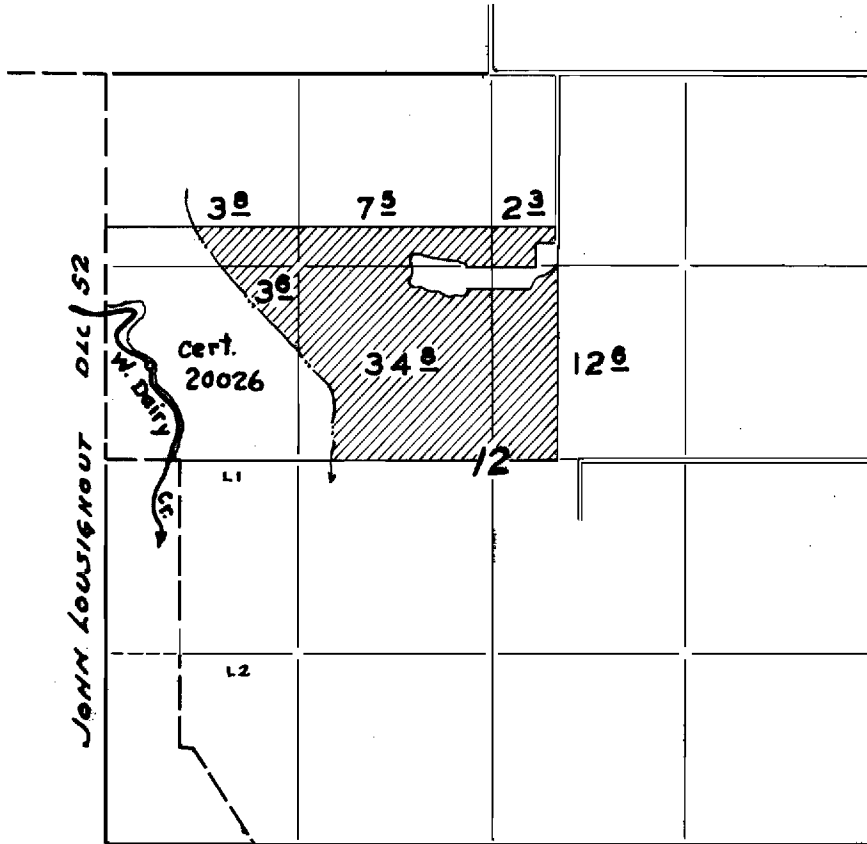

**FINAL PROOF SURVEY**

UNDER

Application No. 25487 Permit No. 20968

IN NAME OF

*Estate of William Susbauer*

Surveyed 4 - 13 1956, by R. H. WHITBY.

DFR-3D-186

WC