


T. 1 N. R. 3 W. W. M

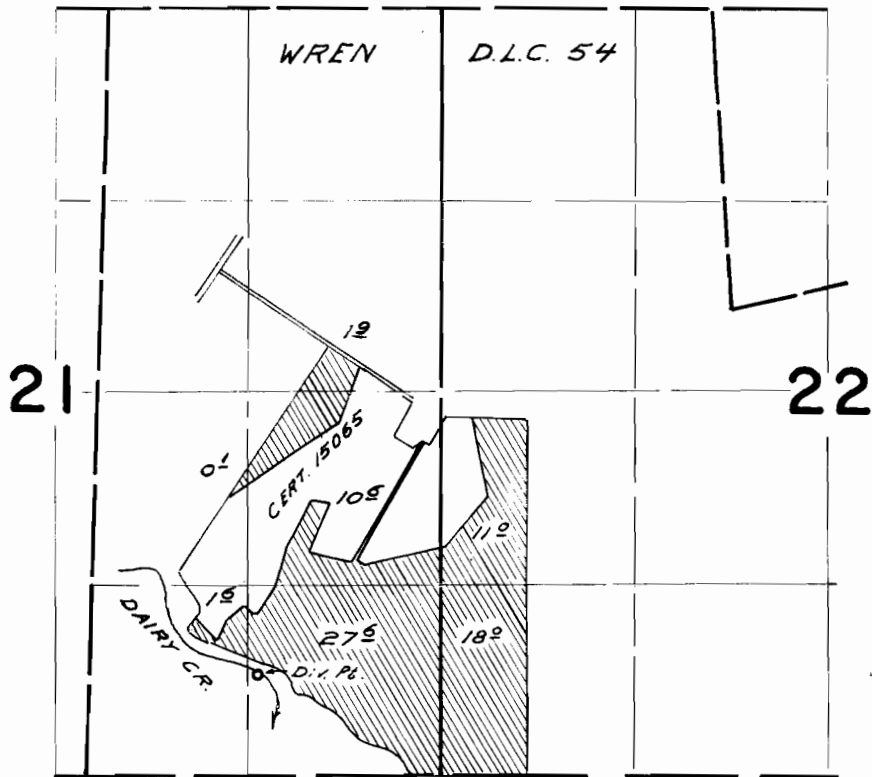

Div. Pl. Located 680 ft N. & 4180 ft W. from SE. Cor. D.L.C. 54

FINAL PROOF SURVEY UNDER

Application No. 37939 Permit No. 28300
IN NAME OF

Roland H. Duyck

Surveyed Aug 26 1966, by W. J. Ruppert