Pond #1

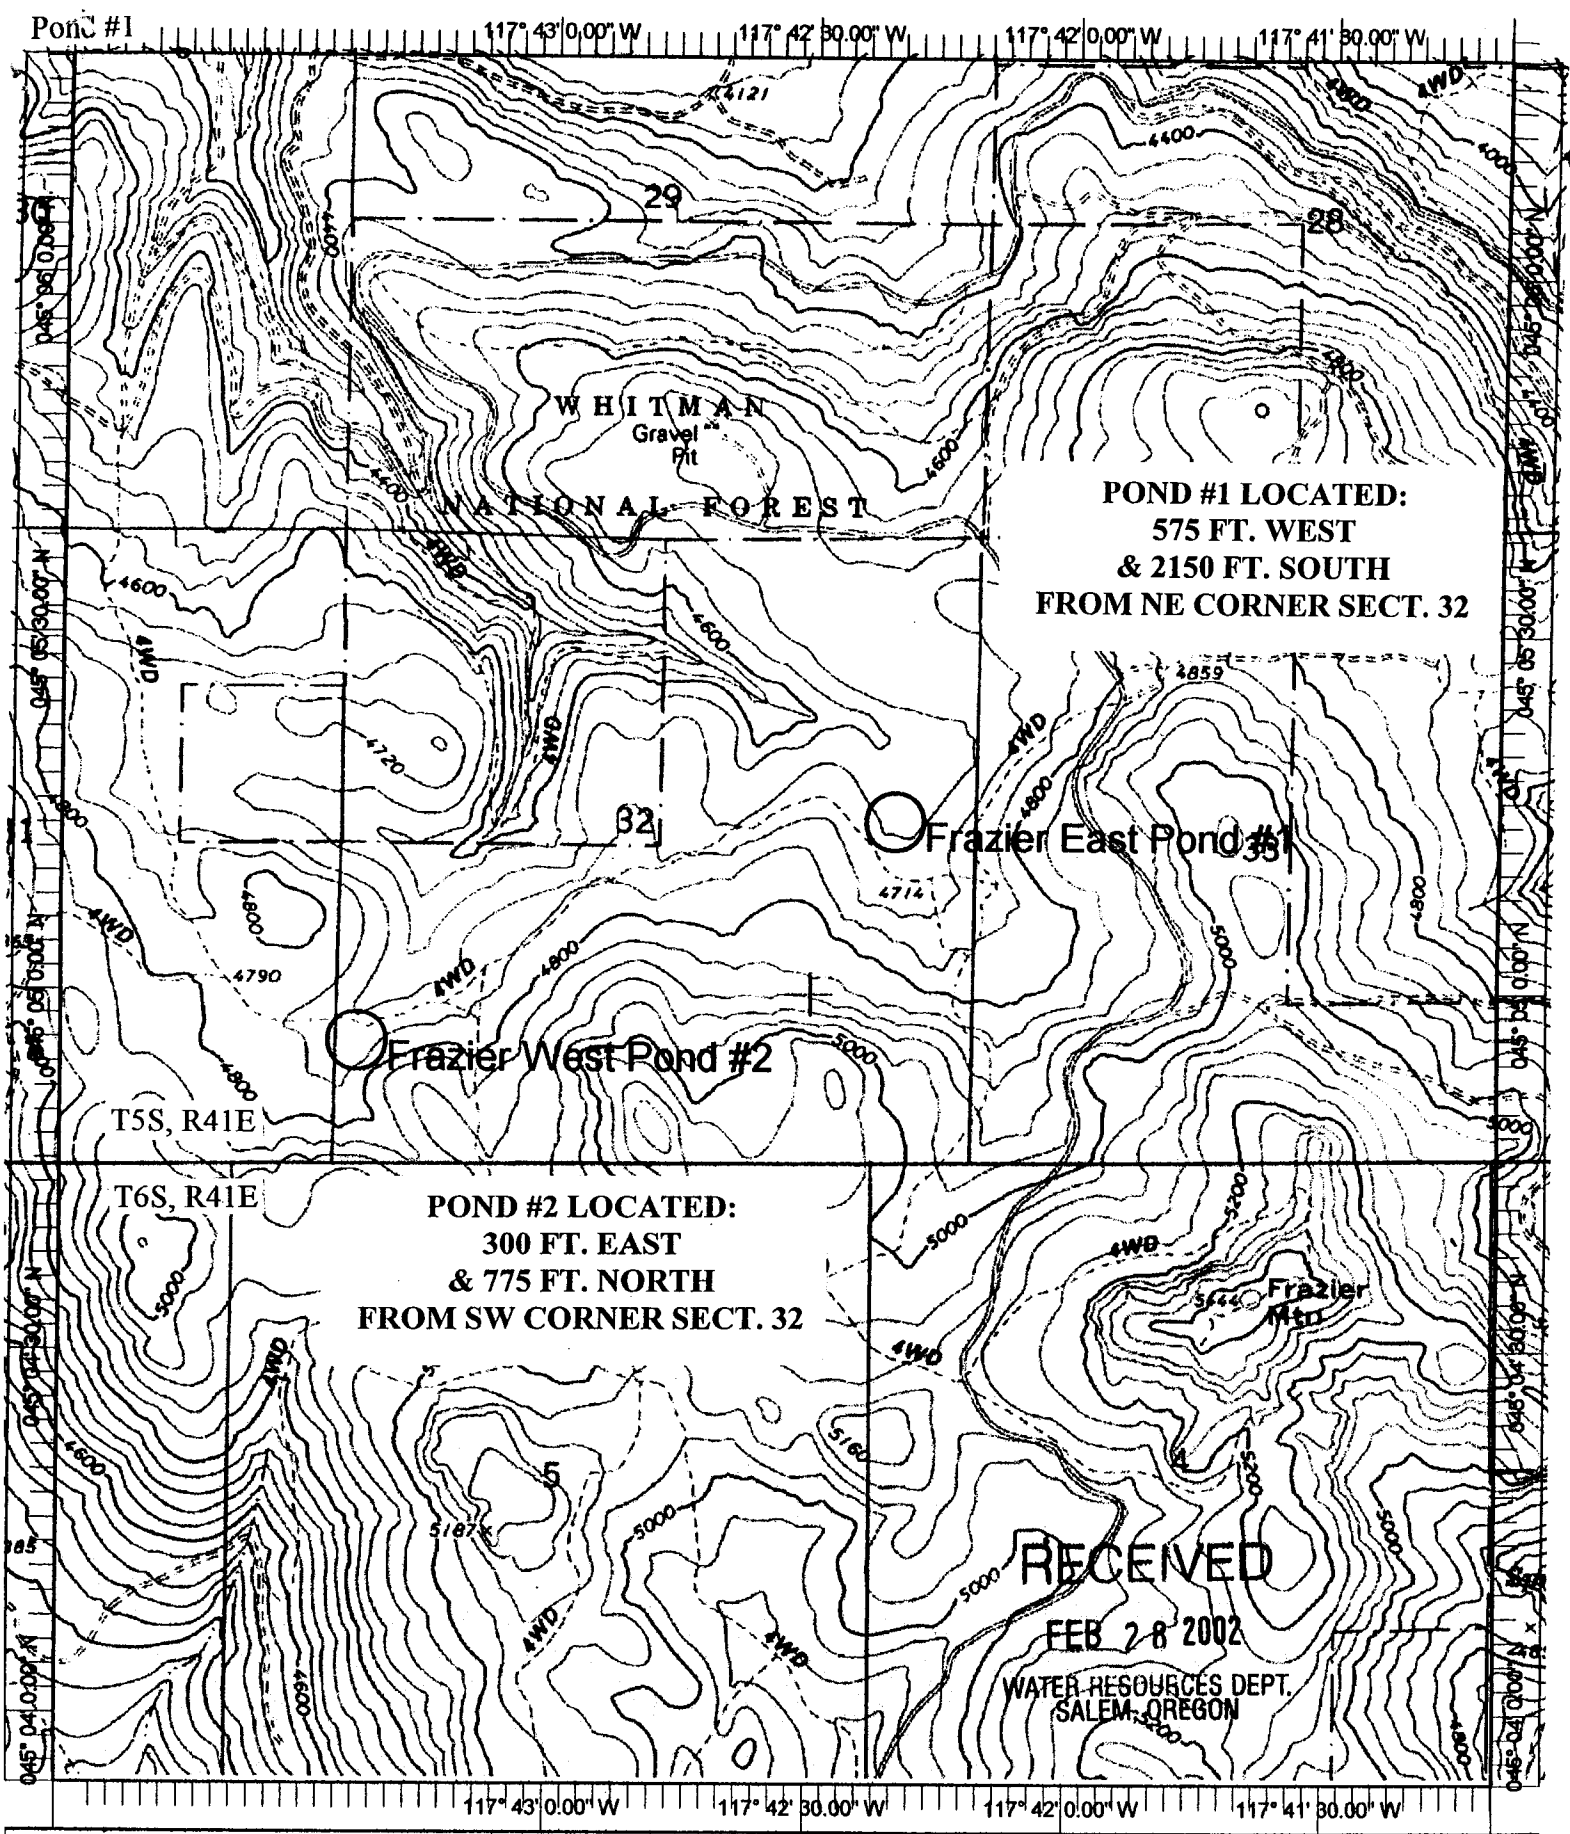


RECEIVED
FEB 28 2002
WATER RESOURCES DEPT.
SALEM, OREGON

Name: MEDICAL SPRINGS
Date: 2/12/2002
Scale: 1 inch equals 1600 feet

Location: 045° 05' 06.2" N 117° 42' 32.8" W
Caption: OWEB Restoration Project
Frazier East Pond #1
Frazier West Pond #2

RECEIVED
MAY 15 2003
WATER RESOURCES DEPT.
SALEM, OREGON

Copyright (C) 1997, Maptech, Inc.

**Application No.** R-85065
**Permit No.** R-13362