


RECEIVED

SEP 20 2002

WATER RESOURCES DEPT.  
SALEM, OREGON

THIS MAP WAS PREPARED FOR  
ASSESSMENT PURPOSE ONLY

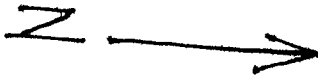

SEE MAP 28 7 29A

20  
21

29  
28  
500  
5366 AC

LOT 3  
21.80

SEE MAP 28-22

PARCEL 1  
489 AC

SEE MAP 28 7 21

NW1/4 SEC. 28 T.28S. R.7 W. W.M.  
DOUGLAS COUNTY  
1400'

RECEIVED  
OCT 04 2004  
WATER RESOURCES DEPT  
SALEM, OREGON

116-14

BRIDGE

140 S. and 150 E  
of North West  
corner of SEC 28

SEE MAP 28 7 28A

CANCELLED NOS  
401

PREPARED ON  
2-25-00

28 7 2

app # R-85294  
Permit # R-13494