


SCALE = 1" = 60'

This map was prepared for measurement purposes only.

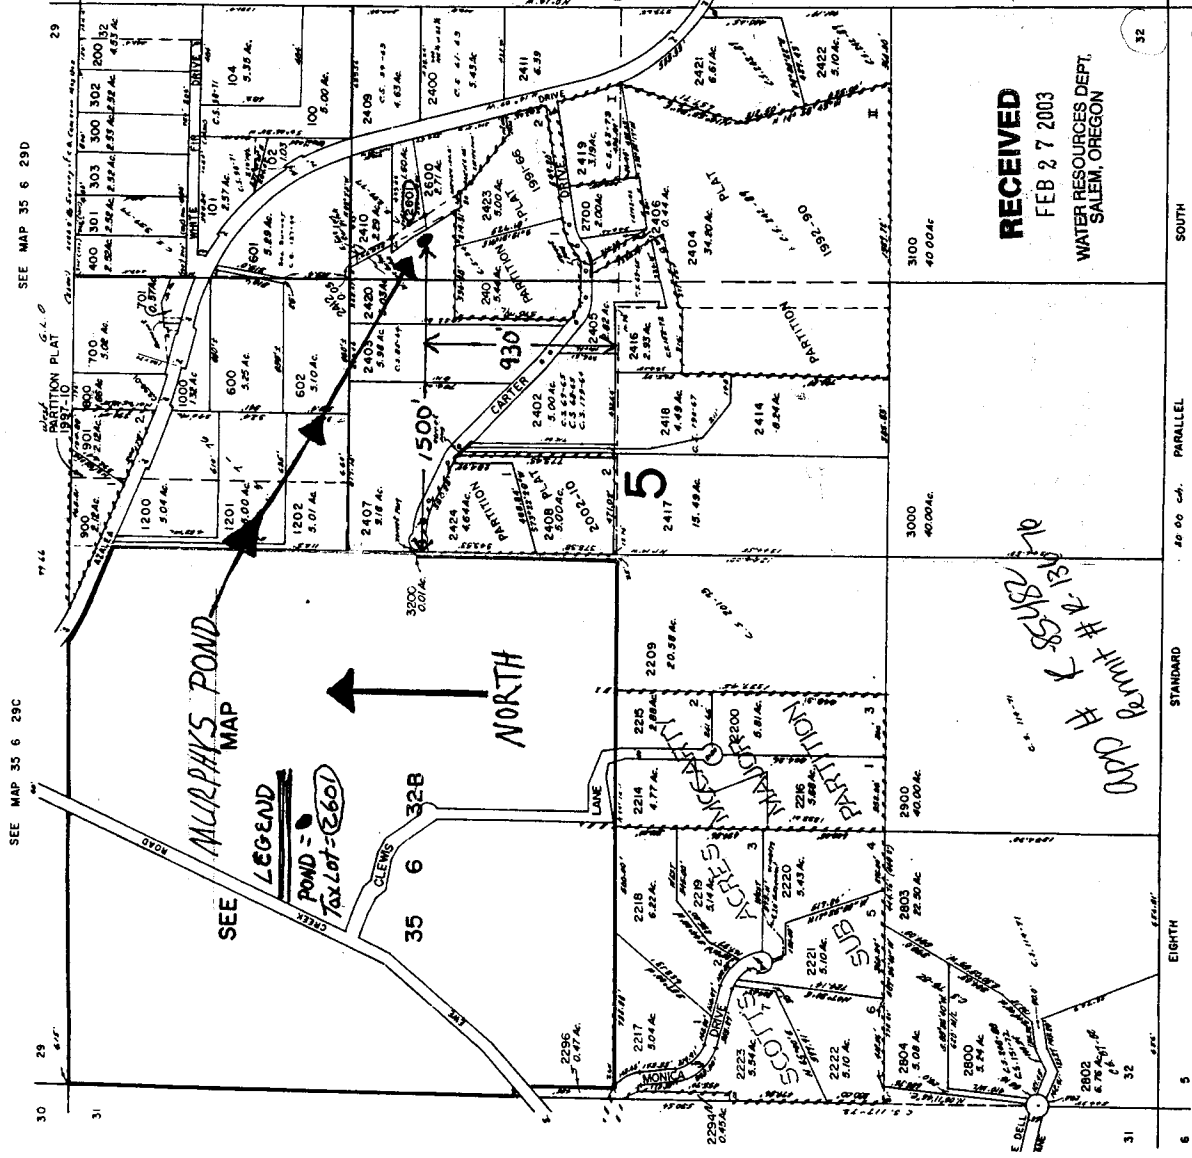

RECEIVED
 SEP 17 2003
 WATER RESOURCES DEPT.
 SALEM, OREGON

RECEIVED
 FEB 27 2003
 WATER RESOURCES DEPT.
 SALEM, OREGON

SEE MAP 35 6 29D

SEE MAP 35 6 29C

SOUTH

40 00 CA. PARALLEL

STANDARD

EIGHTH

5

6

31

32

29

30

31

32


















