

SEC. 15 T.25S. R. 6W W.M.
DOUGLAS COUNTY

WILCOX FAMILY FARM LLC WETLAND ENHANCEMENT
SEE MAP 25 6 10


REVISED ON
6-4-97

RECEIVED

JUN 01 2004

WATER RESOURCES DEPT
SALEM, OREGON

SCALE 1" = 660'

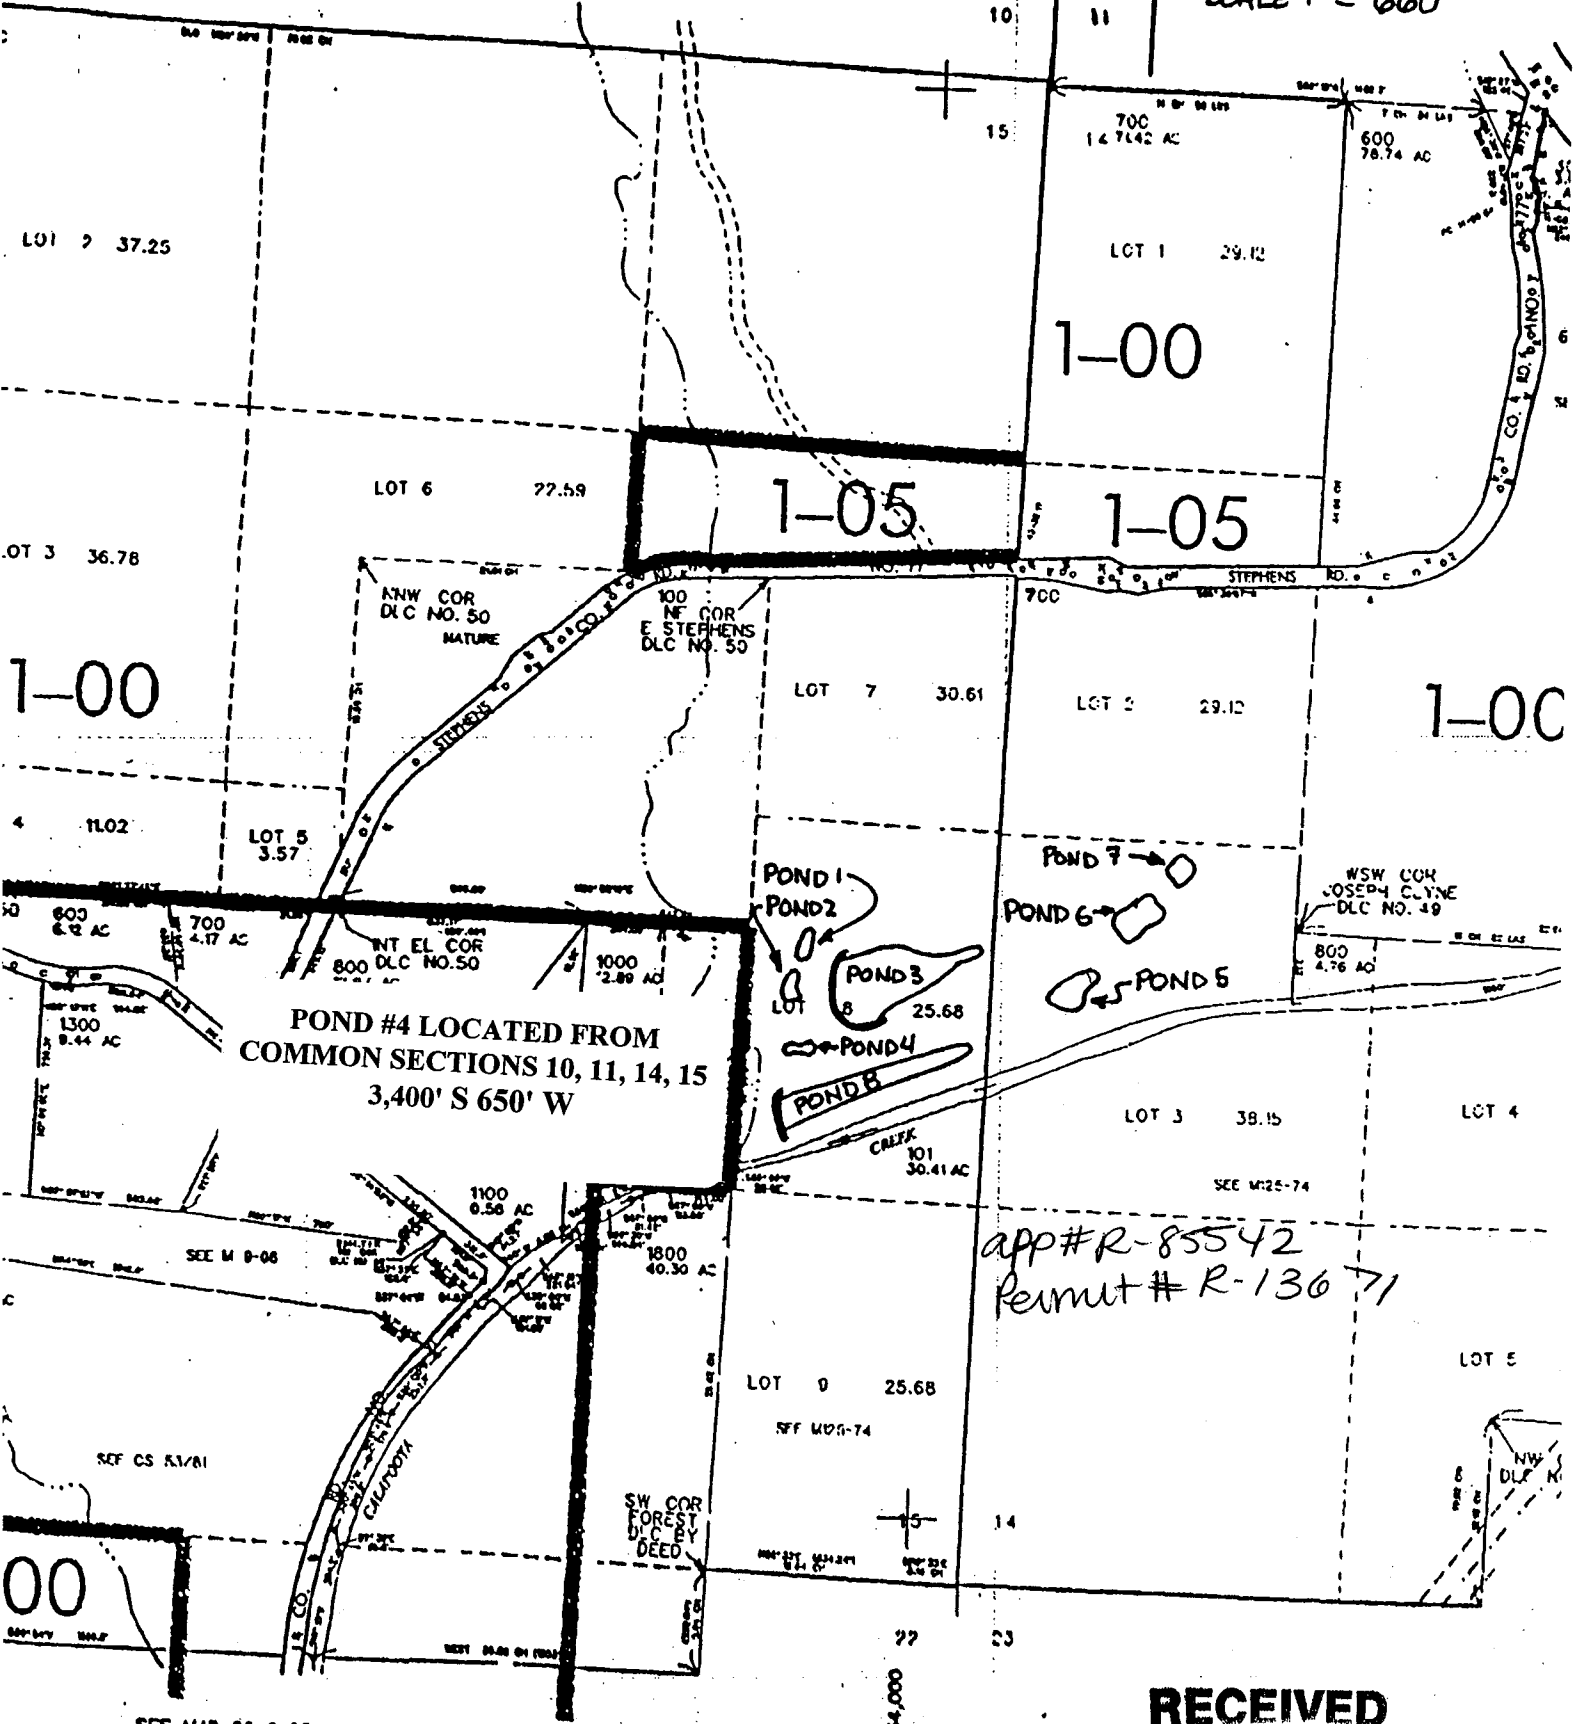

RECEIVED

APR 07 2003