

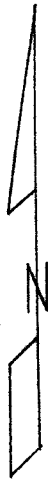


TOWNSHIP 15 SOUTH, RANGE 10 EAST, W.M.

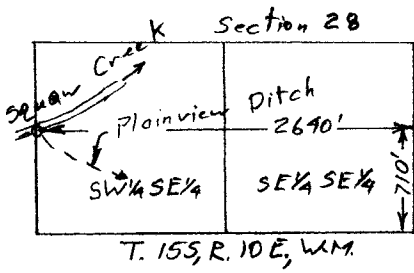

Scale 1" = 1320'


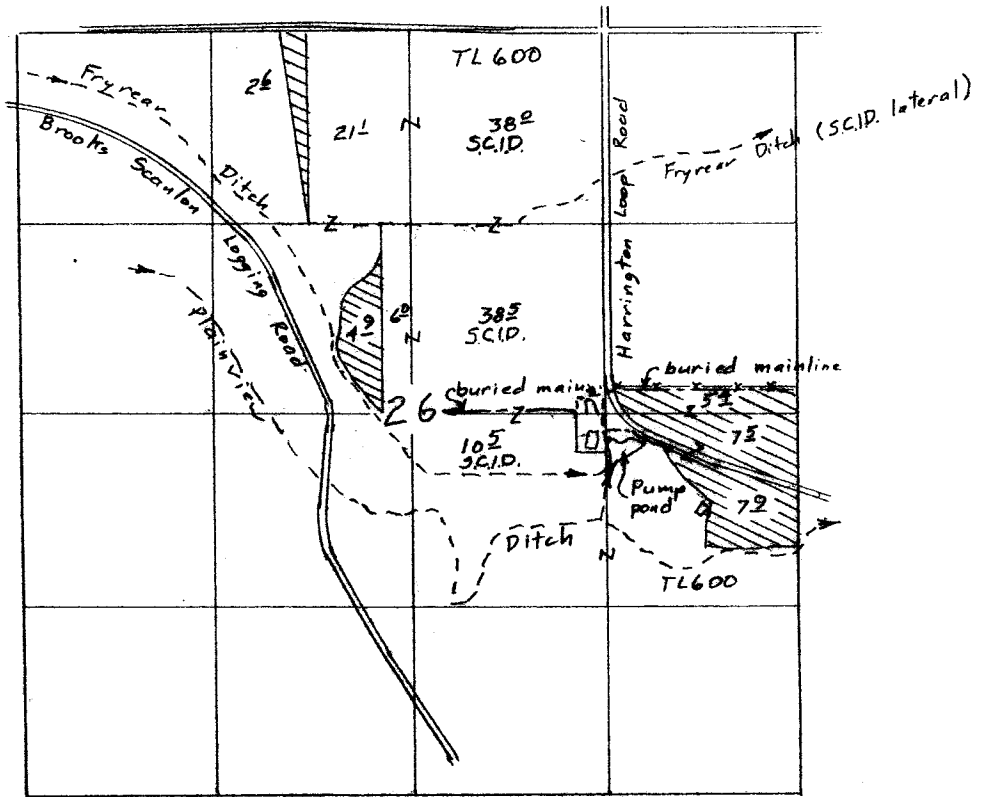


Surveyed Oct 25, 2002

⊙ 1904 Plainview Ditch transferred in 28³ acres

Claim of Beneficial Use Map
for
Weldon Wankier
(Block Diamond Ranch)

T-5591

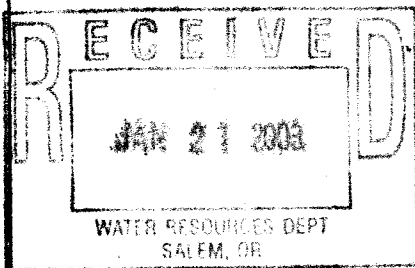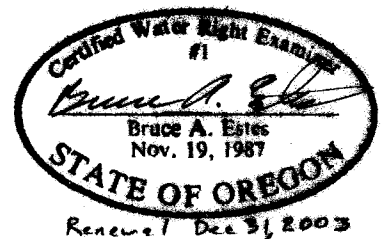

This map is for the purpose of locating a water right only and has no intent to provide legal dimensions or the location of property lines.

ESTES SURVEYS, LLC

PO Box 17519
Salem, OR 97309-7519
(503) 586-7893

60362 Ames St
Bend, OR 97701
(541) 322-7891