


WATER RESOURCES DEPT
SALEM, OREGON

33341 *Rehder Rhodod.*
Chilobogus OR 97624

THIS MAP WAS PREPARED FOR
ASSESSMENT PURPOSE ONLY

WORKING COPY
NE1/4 SEC. 22 T.35S. R.10E. WM.
KLAMATH COUNTY
① 1" = 400'

35 10 22A

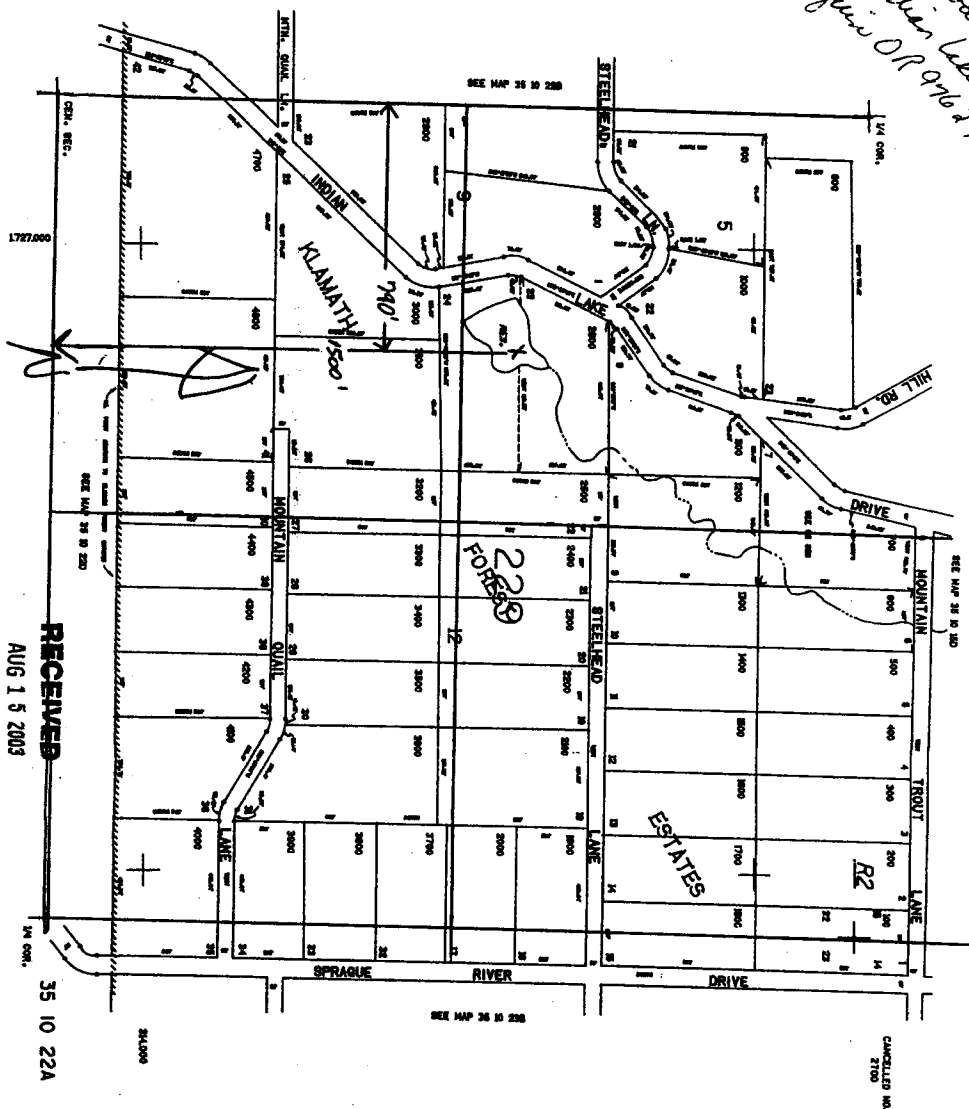

RECEIVED
AUG 15 2003
WATER RESOURCES DEPT.
SALEM, OREGON

app no R-85737.
Permit no R-13031