


RECEIVED

MAR 11 2004

WATER RESOURCES DEPT
SALEM, OREGON

SE1/4 SEC. 9 T.24S. R.5 W. W.M.
DOUGLAS COUNTY
Scale: 1" = 500'

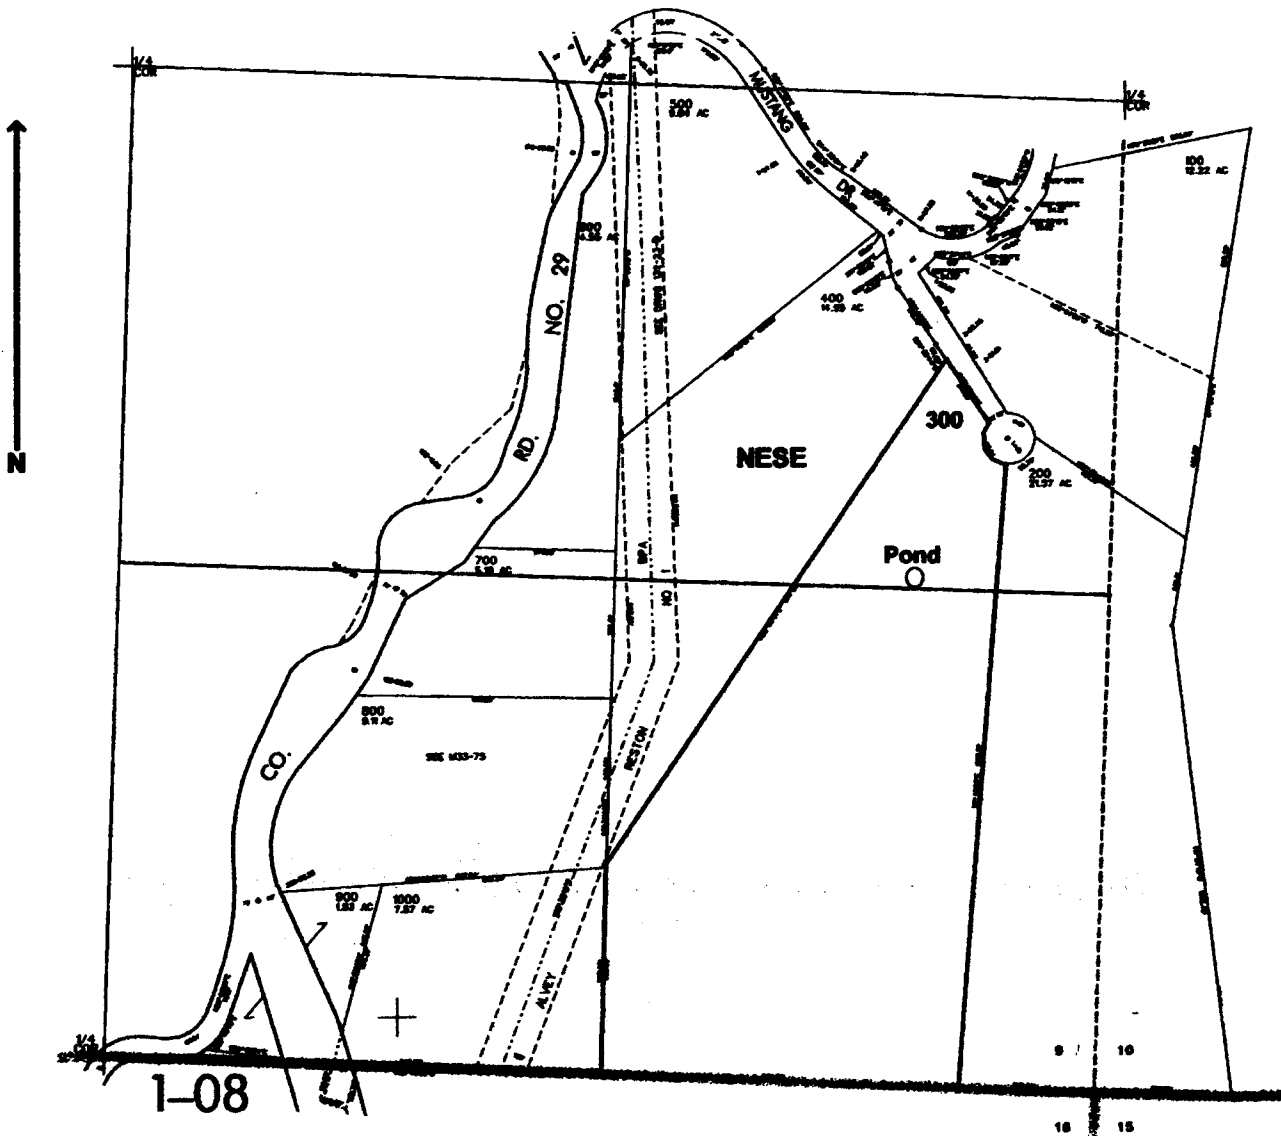

Pond is located 1360 ft. N. and 500 ft. W. from the S.E. corner of Sec. 9

RECEIVED

NOV 18 2003

WATER RESOURCES DEPT
SALEM, OREGON

appno R-85874

Permit no - R-13888