


T. IS. R. IOE. W.M.

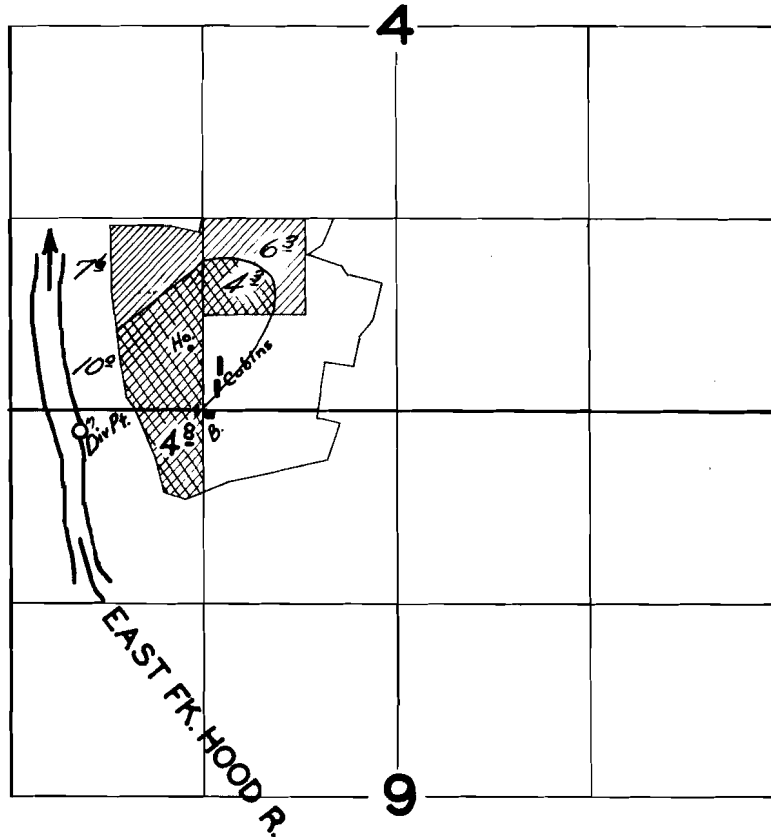

**FINAL PROOF SURVEY**

UNDER

Application No. 20701 Permit No. 16224

IN NAME OF

*Berta Klausner Goetz & Edward Goetz*

Surveyed APR. 24 1957., by *C.O. Burtels*