


T. 1 S. R. 10 E. W.M.

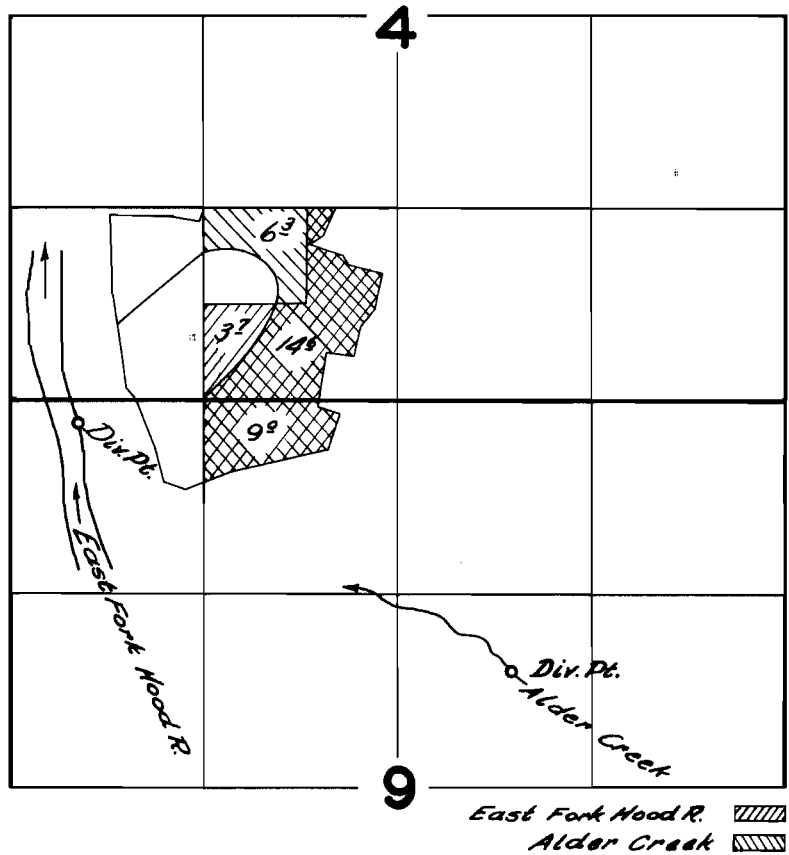

FINAL PROOF SURVEY

UNDER

Application No. 25261, Permit No. 21508.

IN NAME OF

*Berta Klausner Goetz & Edward Goetz*

Surveyed *April 24 1957*, by *C.O. Bartels*