


T.26S.,R.18E.,W.M.

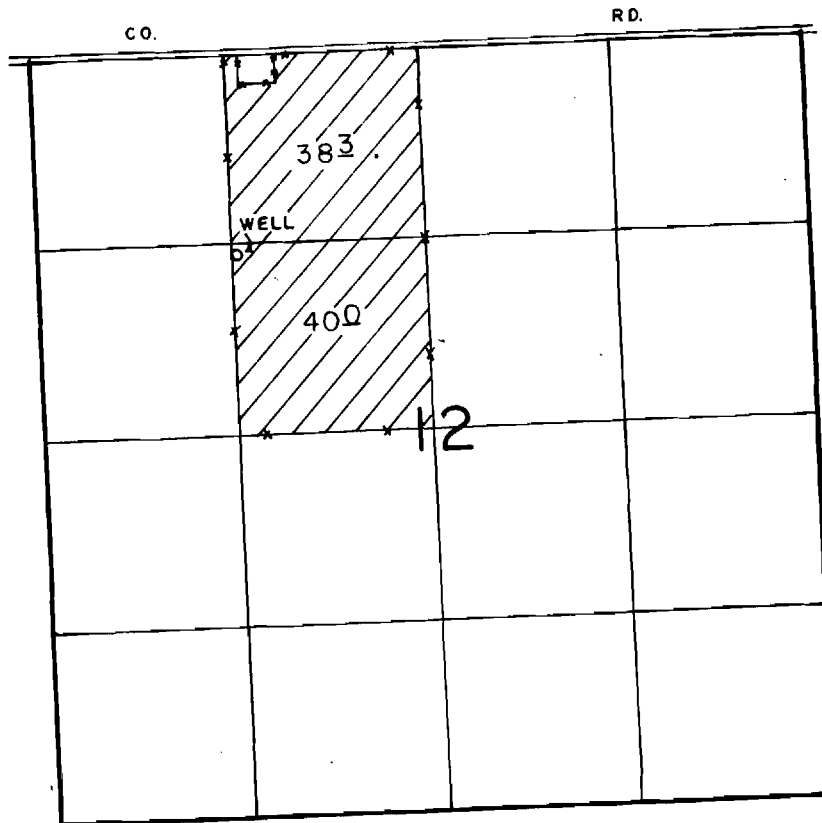

WELL LOC: 1380' S. & 1350' E. FROM NW COR. OF SEC 12.

SCALE 1"=1320'

FINAL PROOF SURVEY
UNDER

Application No. G-10425 Permit No. G-9421.....
IN NAME OF

.....WILLIE A. & LINDA S. OLSON.....

Surveyed APRIL 8, 1992, by B.W. BISHOP.....

MAP TO ACCOM

TO CHANGE


AND CHANGE POIN

FOR

FLOWEREE

EXISTING WATER RIGHTS TO BE TRANSFERRED
AND EXISTING POINT OF APPROPRIATION

LOCATED IN THE E1/2NW1/4 OF SECTION 12
TOWNSHIP 26 SOUTH, RANGE 18 EAST, W.M.
TAX LOT 26-18-2700
LAKE COUNTY, OREGON

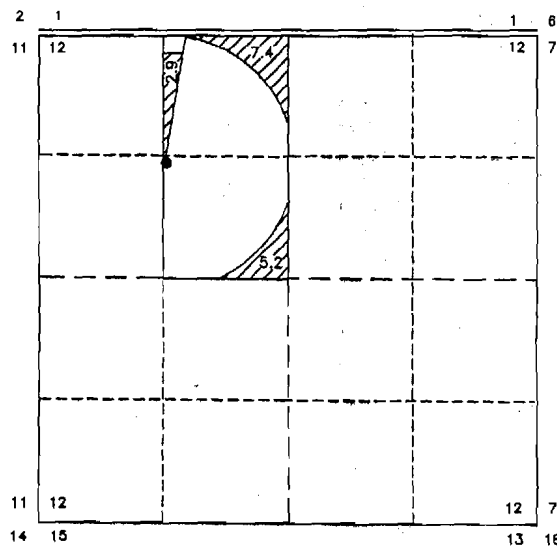

EXISTING POINT OF APPROPRIATION

- EXISTING WELL
LOCATED IN THE SE1/4NW1/4 OF SECTION 12, TOWNSHIP 26
SOUTH, RANGE 18 EAST, W.M., LAKE COUNTY, OREGON
AND LOCATED 1380 FEET SOUTH AND 1350 FEET EAST
FROM THE NORTHWEST CORNER OF SECTION 12.


LEGEND



15.5 ACRES AS PER CERTIFICATE #88202
TO BE TRANSFERRED AS SHOWN.



SCALE 1"=1320'

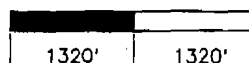

THIS MAP IS FOR T
WATER RIGHT ONLY
LEGAL DIMENSIONS
PROPERTY LINES.