


CLAIM OF BENEFICIAL USE MAP

UNDER APPLICATION R-81931; PERMIT R-12370

NW1/4 NE1/4 SEC 31 T 37S R 41E W.M.

U.S.G.S. QUAD - BLUE MOUNTAIN BASIN, OREG. - 7 1/2'

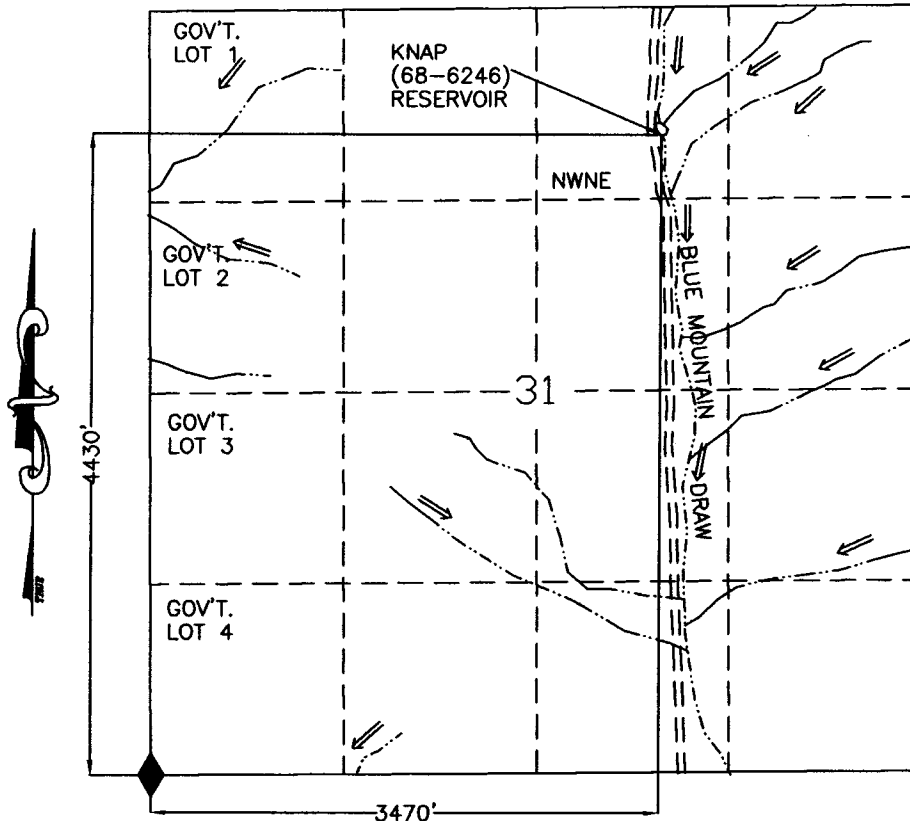

RECEIVED


JUL 03 2003

WATER RESOURCES DEPT.
SALEM, OREGON

LEGEND

- o RESERVOIR
- == ROAD
- - - CHANNEL
- ◆ FD SEC COR

KNAP (68-6246) RESERVOIR

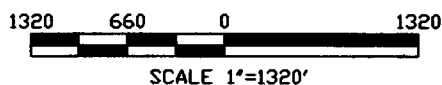

I, Thomas Terry, ADM Operations/Field Services agree to the findings of the CWRE and do submit this site report and map as my Claim of Beneficial Use of the water as provided under the terms and conditions of my Permit R-12370.

Thomas Terry



THIS MAP IS FOR THE PURPOSE OF LOCATING A WATER RIGHT AND IS NOT INTENDED TO PROVIDE LEGAL DIMENSIONS FOR LOCATION OF PROPERTY BOUNDARIES.

ACAD2000/LDD
DWG FILE: KNAPBEN

UNITED STATES DEPARTMENT OF THE INTERIOR
BUREAU OF LAND MANAGEMENT
DIVISION OF OPERATIONS VALE DISTRICT

KNAP (68-6246) RESERVOIR

DRAWN BY: *[Signature]*
SURVEYED: *[Signature]*
APPROVED: *[Signature]*
ADM OPERATIONS AND FIELD SERVICES

DRAWN: CG SCALE: 1"=1820'

DATE: 11/01/01 SHEET 1 OF 1

DRAWING NO. OR-03-9172.45-1103