



T.23S., R.31E., W.M.

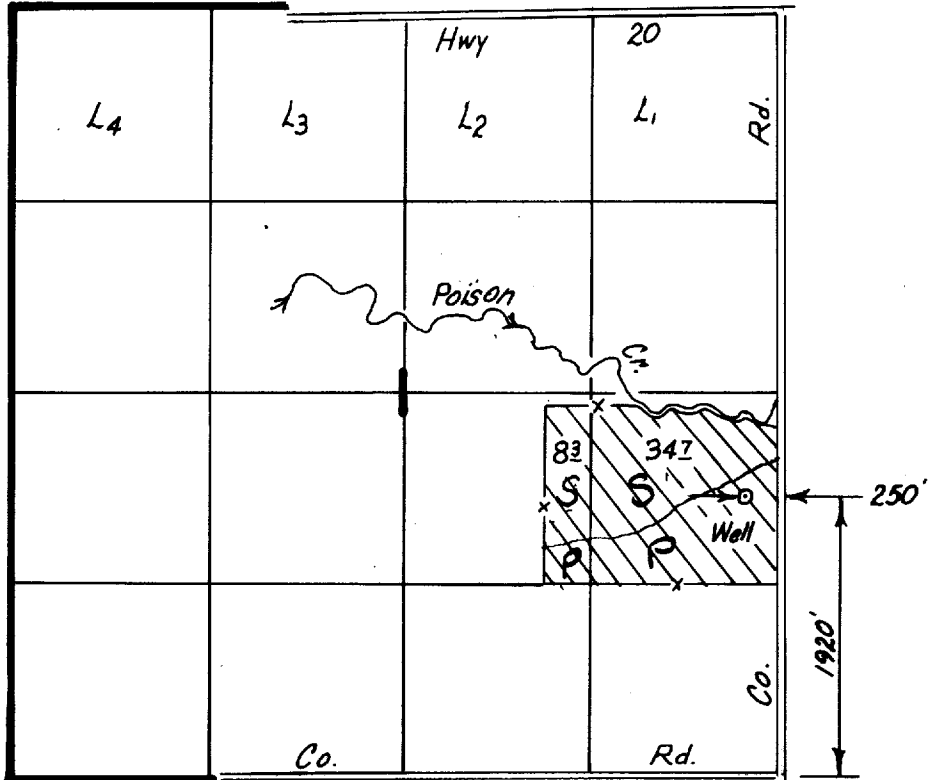

FINAL PROOF SURVEY UNDER

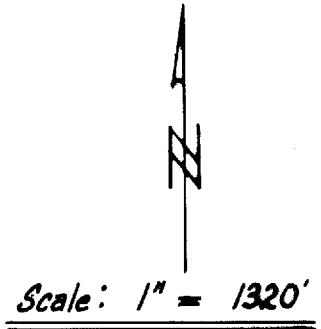

Application No. **G10437** Permit No. **G9805**...
IN NAME OF

Department Of Veterans' Affairs.....

Surveyed ...5-10... 1988., by *Mike Schmarde*