



T.39 S., R.20 E., W.M.

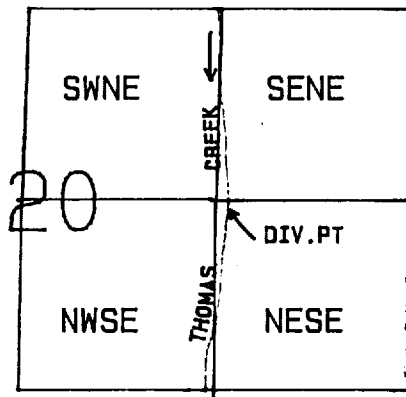

SCALE: 1 IN. = 1320

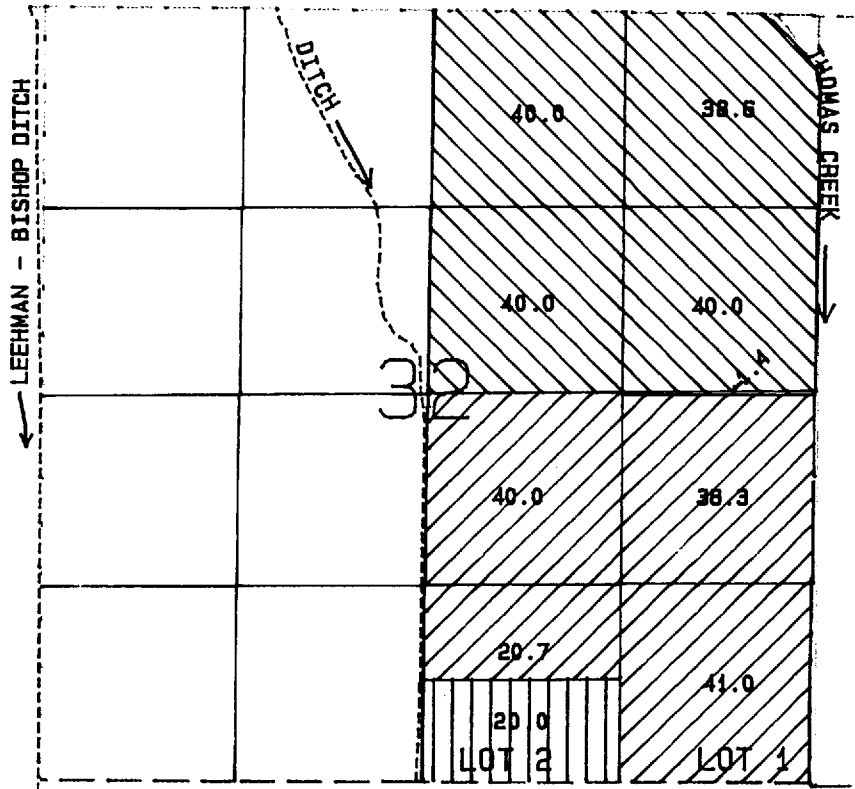

DIV. PT LOCATED 2630 FT. S. AND 4040 FT. E. FROM NW. COR. SEC. 20

FINAL PROOF SURVEY

UNDER



TRANSFER No. T-4421



TRANSFER NO. T-4422



APPLICATION NO. 59852 PERMIT NO. 44976

IN NAME OF

J. BOYD TAYLOR

Surveyed Oct. 16, 1987 By V.L. CHURCH

Photo: 379-69C, 70B & 70L DLM