


T.39 S., R.20 E., W.M.

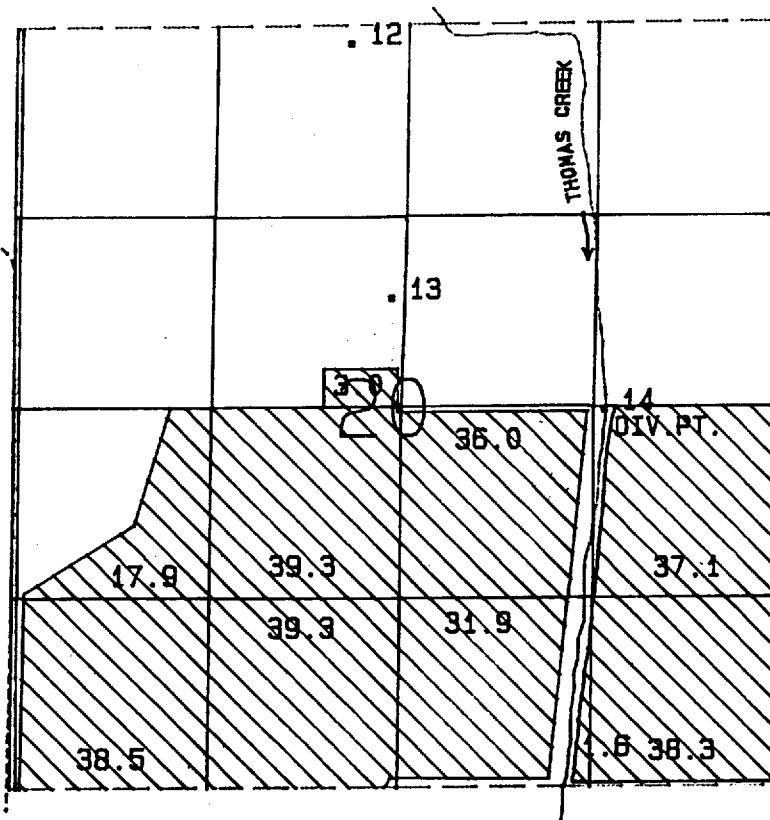

SCALE: 1 = 1320

DIV.PT. LOCATED 2630 FT. S. AND 4040 FT. E. FROM NW. COR. SEC. 20

FINAL PROOF SURVEY
UNDER

TRANSFER NO. 4423

IN NAME OF

J. BOYD AND JOSEPHINE TAYLOR

Surveyed Oct. 16, 1987 By V.L. CHURCH

Photo: 379-70L JCL