


R-85530

SEC. 6 T.24S. R. 4W W.M.
DOUGLAS COUNTY

Scale: 1" = 1000'

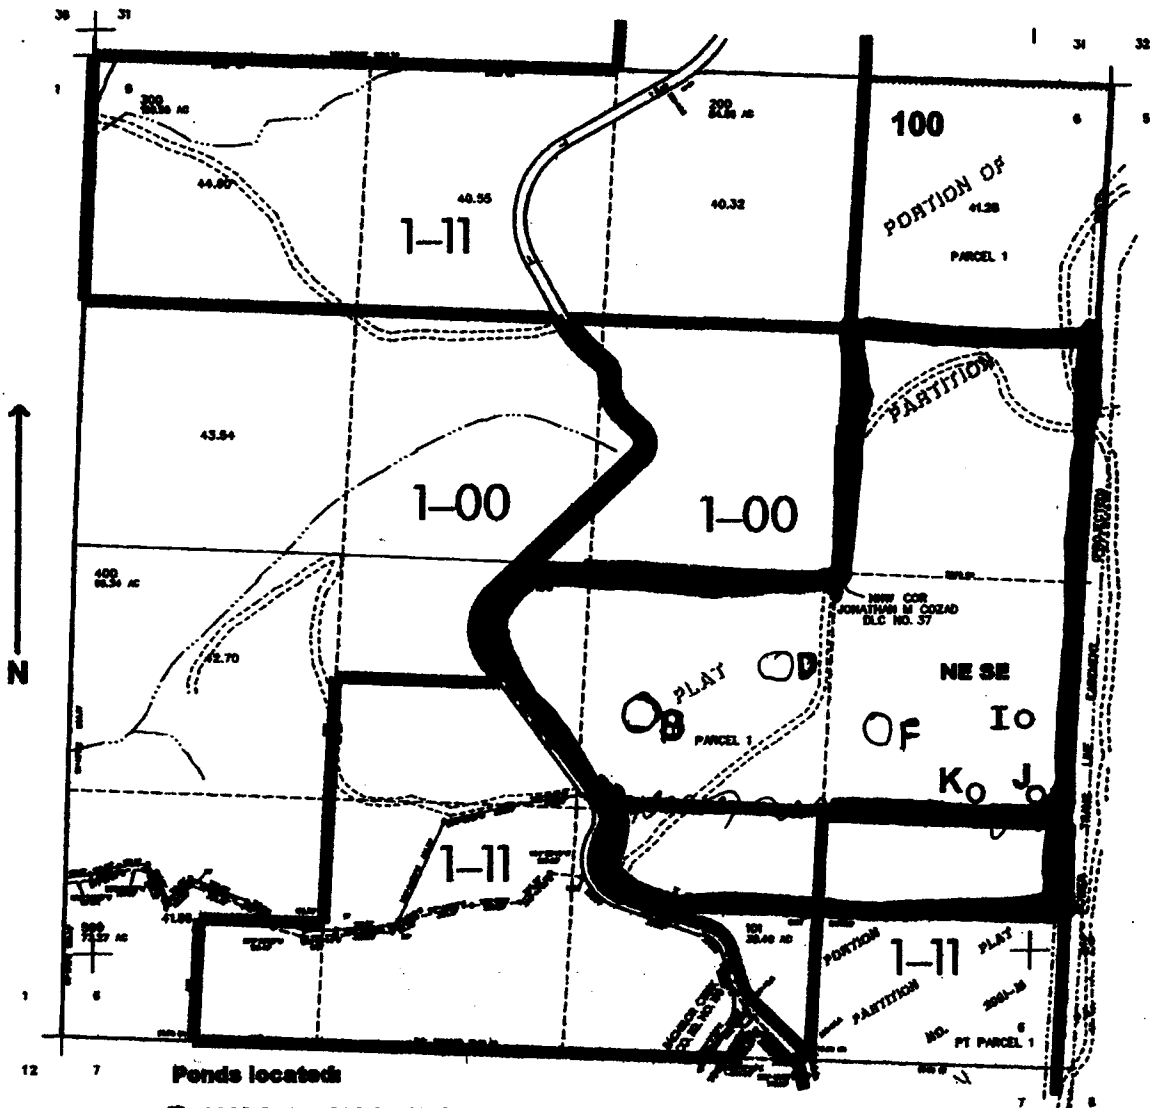

Ponds located:
I 1820 ft. N. 250 ft. W. }
J 1420 ft. N. 180 ft. W. } All from the SE corner of Sec. 6
K 1420 ft. N. 500 ft. W. }

RECEIVED
NOV 03 2004
WATER RESOURCES DEPT
SALEM, OREGON